

SURVEY & REMONUMENTATION

MAR 03 1998

KENT COUNTY REMONUMENTATION

LAND CORNER RECORDATION CERTIFICATE
Filing Requirement of Act 74, Mich. P.A. 1970

STATE OF MICHIGAN
COUNTY OF KENT
RECEIVED FOR RECORD
97 APR 29 AM 8:27
REG. OF DEEDS
Luci Stand

For corners in **SECTION**
KENT COUNTY
(County)

Located In: Corner Code #

1. Public Land Survey	T <u>6N</u> R <u>9W</u>	M-10
	T _____ R _____	_____
	T _____ R _____	_____
	T _____ R _____	_____
2. Property Controlling in Section	S _____ T _____ R _____	_____
	S _____ T _____ R _____	_____
3. Miscellaneous Property in Sec.	S _____ T _____ R _____	_____
	S _____ T _____ R _____	_____

9897

Register of Deeds Stamp & File Number

4. Lot No. _____, Recorded Plat _____
5. Private Claims _____

	A	B	C	D	E	F	G	H	I	J	K	L	M
1													
2	6		5		4		3		2		1		
3													
4	7		8		9		10		11		12		
5													
6	18		17		16		15		14		13		
7													
8	19		20		21		22		23		24		
9													
10	30		29		28		27		26		25		
11													
12	31		32		33		34		35		36		
13													

I, Kirk Breitels, in a field survey on Mar. 18, 1997 do hereby state that under requirements of P.A. 74, Michigan P.A. of 1970, the corner points mentioned in lines 1 and 2 above were in conformance with regulations and rules therefore as required in the current manual of survey instructions of the United States Department of the Interior, Bureau of Land Management or by a decree of a Court of Law and/or that the corner points mentioned in lines 3, 4 and 5 above were in conformance with the rules of the Michigan Board of Land Surveyors or by a Decree of a Court of Law; established, re-established, monumented, recovered, found as expressed below:

NOTE: Not more than 2 corners, all in the same town and range, may be recorded on this certificate.

A. Description of original monument and accessories and/or subsequent restoration:

M-10	1830	GLO	Mullett	Set Post
	1959	Kent Co. Wit.		1/2" Iron
	1983	LCRC #3360	Bissell	Set 1" Pipe with cap
	1983	LCRC #3604	Kolehouse	Set Kent County Monument
	1990	LCRC #5462	Starr	Kent County Monument

The position of this corner was previously approved by the Kent County Remonumentation Peer Group, monumented by Randy J. Kolehouse on 11/2/83 and was recorded per LCRC #3604

B. Description of corner evidence found and/or method applied in restoring or reestablishing corner:

M-10 Found standard Kent Co. Mon. (Harrison) LEANNING EAST per witnesses from above LCRC as set by Randy J. Kolehouse in place of the 1" Capped Iron he found. Said Capped Iron checks LCRC #3604. Kent Co. Wit. for A-10, T6N, R8W? REMOVED/RESET monument per wits. LCRC #3604


Nail & tag 10" Cottonwood	S58°E 22.60'	Nail & tag Tw. 10" Tree	S85°W 24.46'
Nail & tag 14" Ash	S02°E 81.0'	Nail & tag P. Pole	N15°E 80.93' (88.9' M)
Nail & tag 8" Cottonwood	N40°E 20.55'	E. edge of E. rail	West 47.26'
E. edge of E. rail	West 47.26'	Iron @ W 1/4 cor. 30-6-8	North 13.42'
Iron @ W 1/4 cor. 30-6-8	North 13.42'		

The selected location is accepted by me and is generally accepted by professional surveyors as the best available evidence of the position of the original corner.

C. Description of monument for corner and accessories established to perpetuate locating the position of the corner:

M-10 Standard Kent County Monument

Nail & DNR tag (per LCRC #3360) N. side Tele. Pole	S70°W	98.10'
East edge of East rail	West	47.26'
Iron Pipe (W 1/4 cor. Sec. 30-6-8)	North	13.42'
Nail & KC Remon. tag E. side P. Pole	N15°E	88.89'
Nail & KC Remon. tag S. side Tw. 12" Tree	S85°W	24.24'
PK Nail & KC Remon. tag N. end RR crossing (C/L ±)	N45°W	63.15'
C/L North-South gravel road is 7' West ±		

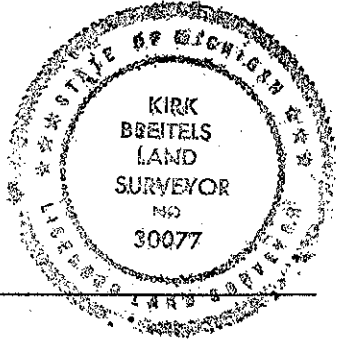

Signed by *Kirk Breitels*
Surveyor's Michigan License No. 30077

Date 3/27/97

P.A. 345 1990 KENT COUNTY
PEER APPROVED 3/27/97
CHAIRMAN *Harry Kuebel*