

KENT COUNTY REMONUMENTATION

LAND CORNER RECORDATION CERTIFICATE  
Filing Requirement of Act 74, Mich. P.A. 1970

For corners in  
KENT COUNTY  
(County)

Located In:	Corner Code #
T6N R9W	M-13
T5N R9W	M-1
T R	
T R	Common Corner
S T R	
S T R	
S T R	
S T R	

- Public Land Survey
- Property Controlling in Section
- Miscellaneous Property in Sec.

4. Lot No. \_\_\_\_\_, Recorded Plat \_\_\_\_\_  
5. Private Claims \_\_\_\_\_

STATE OF MICHIGAN  
 COUNTY OF KENT  
 RECEIVED FOR RECORD  
 97 JUN -3 AM 8:11  
 REG. OF DEEDS  
 9998  
 Register of Deeds Stamp & File Number

I, Kirk Breitels, in a field survey on May 15, 1997 do hereby state that under requirements of P.A. 74, Michigan P.A. of 1970, the corner points mentioned in lines 1 and 2 above were in conformance with regulations and rules therefore as required in the current manual of survey instructions of the United States Department of the Interior, Bureau of Land Management or by a decree of a Court of Law and/or that the corner points mentioned in lines 3, 4 and 5 above were in conformance with the rules of the Michigan Board of Land Surveyors or by a Decree of a Court of Law; established, re-established, monumented, recovered, found as expressed below:

	A	B	C	D	E	F	G	H	I	J	K	L	M
1													
2	6		5		4		3		2		1		
3													
4	7		8		9		10		11		12		
5													
6	18		17		16		15		14		13		
7													
8	19		20		21		22		23		24		
9													
10	30		29		28		27		26		25		
11													
12	31		32		33		34		35		36		
13													

NOTE: Not more than 2 corners, all in the same town and range, may be recorded on this certificate.

A. Description of original monument and accessories and/or subsequent restoration:

M-13/M-1 1830	GLO	Mullett	Set Post
1936	Kent Co. Wit.		Conc. Mon.
1985	LCRC #4110	Jonker	Set Kent County Monument
1990	LCRC #5463	Starr	Kent County Monument

The position of this corner was previously approved by the Kent County Remonumentation Peer Group, monumented by Robert J. Jonker on 1/21/85 and was recorded per LCRC #4110

B. Description of corner evidence found and/or method applied in restoring or reestablishing corner:


M-13/M-1 Found standard Kent Co. Mon. (Harrison) per witnesses from above LCRC as set Robert J. Jonker by in place of the Conc. Mon. he found. Said Conc. Mon. checks with Kent Co. Wit.

LCRC #4110	LCRC #5463
Remon. tag 8" Maple cl. N30°W 75.17'	Nail & tag 8" Maple cl. N30°W 75.17'
Remon. tag 8" Oak S10°E 39.8'	Nail & tag 8" Oak S10°E 39.80'
Remon. tag 14" Willow S70°E 6.64'	Nail & tag 14" Willow S70°E 6.64'
E. edge of rail West 139.55'	E. edge of rail West 139.55'
	Nail & tag 8" Maple N60°W 34.37'

The selected location is accepted by me and is generally accepted by professional surveyors as the best available evidence of the position of the original corner.

C. Description of monument for corner and accessories established to perpetuate locating the position of the corner:

M-13/M-1 Standard Kent County Monument	
Nail & KC Remon. tag W. side 8" Maple	S10°E 39.82'
Nail & KC Remon. tag SW side 14" stump	S70°E 6.67'
Nail & KC Remon. tag S. side 8" Maple	N60°W 34.37'
Nail & KC Remon. tag SW side 10" Poplar	S40°E 30.93'
E. edge bottom of E. rail (along sec. line)	West 139.55'
At S. side of pond, 0.5'± under water	

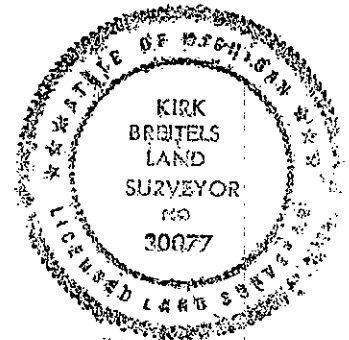

Signed by Kirk Breitels  
Surveyor's Michigan License No. 30077

Date 5/22/97

P.A. 345 1990 KENT COUNTY  
PEER APPROVED 5/22/97  
CHAIRMAN Harry Hubert