

SURVEY & REMONUMENTATION

MAR 03 1998

KENT COUNTY REMONUMENTATION

SECTION

LAND CORNER RECORDATION CERTIFICATE
Filing Requirement of Act 74, Mich. P.A. 1970

For corners in

KENT COUNTY

(County)

Located In:

Corner Code #

1. Public Land Survey

T ___ R ___
T ___ R ___
T ___ R ___
T ___ R ___

2. Property Controlling in Section

S 8 T 6NR 9W

Wit. Mon. on W. Sec. line

3. Miscellaneous Property in Sec.

S ___ T ___ R ___
S ___ T ___ R ___
S ___ T ___ R ___

4. Lot No. _____, Recorded Plat _____
5. Private Claims _____

I, Kirk Breitels, in a field survey on Jan. 14, 1997 do hereby state that under requirements of P.A. 74, Michigan P.A. of 1970, the corner points mentioned in lines 1 and 2 above were in conformance with regulations and rules therefore as required in the current manual of survey instructions of the United States Department of the Interior, Bureau of Land Management or by a decree of a Court of Law and/or that the corner points mentioned in lines 3, 4 and 5 above were in conformance with the rules of the Michigan Board of Land Surveyors or by a Decree of a Court of Law; established, re-established, monumented, recovered, found as expressed below:

NOTE: Not more than 2 corners, all in the same town and range, may be recorded on this certificate.

other code # 10

STATE OF MICHIGAN
COUNTY OF KENT
RECEIVED FOR RECORD
97 APR 29 AM 8:21
REG. OF DEEDS
801
Register of Deeds Stamp & File Number

	A	B	C	D	E	F	G	H	I	J	K	L	M
1													
2	6		5		4		3		2		1		
3													
4	7		8		9		10		11		12		
5													
6	18		17		16		15		14		13		
7													
8	19		20		21		22		23		24		
9													
10	30		29		28		27		26		25		
11													
12	31		32		33		34		35		36		
13													

A. Description of original monument and accessories and/or subsequent restoration:

1830	GLO	Mullett	Set Post
1944	Williams & Works		Held fence line at N. bank of Grand River for Section line North of the Grand River
1991	LCRC #5766	Chettleburgh	Set Harrison monument with Witness Cap

B. Description of corner evidence found and/or method applied in restoring or reestablishing corner:


Found Harrison Monument with witness cap per witnesses from above LCRC as set by Thomas Chettleburgh in place of a "T" Iron and Iron Pipe he found on the North bank of the Grand River. Irons fit Williams & Works information.

Nail & KC Remon. tag NW side 5" Elm	N70°E	4.08'	C-4 (KCM):	S01°02'15E	465.31'
Nail & KC Remon. tag NE side 7" Maple	S20°E	19.82'			
Nail & KC Remon. tag NW side Tw. 24" Maple	S72°W	43.60'	C-3 (KCM):	N00°15'04"E	2177.51'
Nail & KC Remon. tag N. side 16" Ash	S84°W	63.64'			
Nail & KC Remon. tag S. side 10" Elm	N79°W	34.20'			
Nail & KC Remon. tag NE side 17" Maple	N23°W	54.66'			

The selected location is accepted by me and is generally accepted by professional surveyors as the best available evidence of the position of the corner.

C. Description of monument for corner and accessories established to perpetuate locating the position of the corner:

Harrison Monument with witness cap			
Nail & KC Remon. tag NW side 10" Elm	N70°E	4.10'	
Nail & KC Remon. tag NE side 12" Maple	S20°E	19.87'	
Nail & KC Remon. tag NW side Tw. 27" Maple	S72°W	43.60'	
Nail & KC Remon. tag N. side 18" Ash	S84°W	63.62'	
Nail & KC Remon. tag S. side 10" dead Elm	N79°W	34.23'	
Nail & KC Remon. tag NE side 24" Maple	N23°W	54.66'	
N. bank of Grand River is S. 50'±			
C/L E-W path is N. 12'±			

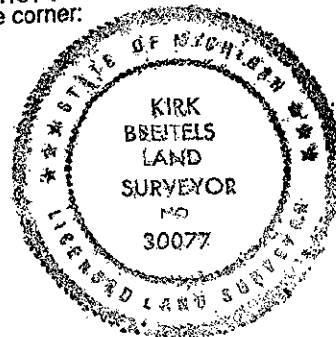

Signed by

Kirk Breitels

Date

3/27/97

Surveyor's Michigan License No. 30077

P.A. 345 1990 KENT COUNTY

PEER APPROVED 3/27/97

CHAIRMAN Harry Huber