

SURVEY & REMONUMENTATION

MAR 03 1998

SECTION

KENT COUNTY REMONUMENTATION

LAND CORNER RECORDATION CERTIFICATE
Filing Requirement of Act 74, Mich. P.A. 1970

For corners in
KENT COUNTY

Located In:	Corner Code #
1. Public Land Survey	T ___ R ___
	T ___ R ___
	T ___ R ___
	T ___ R ___
2. Property Controlling in Section	S 22 T 6N R 9W
	S ___ T ___ R ___
3. Miscellaneous Property in Sec.	S ___ T ___ R ___
	S ___ T ___ R ___

other code # 5
 REG. OF DEEDS
 17 NOV 13 PM 1:01
 STATE OF MICHIGAN
 COUNTY OF KENT
 RECEIVED FOR RECORD

10278

Register of Deeds Stamp & File Number

4. Lot No. _____, Recorded Plat _____
 5. Private Claims _____

I, Kirk Breitels, in a field survey on Aug. 18, 1997 do hereby state that under requirements of P.A. 74, Michigan P.A. of 1970, the corner points mentioned in lines 1 and 2 above were in conformance with regulations and rules therefore as required in the current manual of survey instructions of the United States Department of the Interior, Bureau of Land Management or by a decree of a Court of Law and/or that the corner points mentioned in lines 3, 4 and 5 above were in conformance with the rules of the Michigan Board of Land Surveyors or by a Decree of a Court of Law, established, re-established, monumented, recovered, found as expressed below:

1	A	B	C	D	E	F	G	H	I	J	K	L	M
2		6		5		4		3		2		1	
3													
4		7		8		9		10		11		12	
5													
6		18		17		16		15		14		13	
7													
8		19		20		21		22		23		24	
9													
10		30		29		28		27		26		25	
11													
12		31		32		33		34		35		36	
13													

NOTE: Not more than 2 corners, all in the same town and range, may be recorded on this certificate.


A. Description of original monument and accessories and/or subsequent restoration:
 Not Set by GLO
 See LCRC # 10274 for Central 1/4 corner (H-8) of Sec. 22

B. Description of corner evidence found and/or method applied in restoring or reestablishing corner:
 Set point on N-S 1/4 line 2302.57' South of the N 1/4 corner of Sec. 22 and 341.64' North of the C 1/4 corner referred to in "A". Said point is at the corner ± of a wooded area to North & East. Fence to North is East 3'±.

The location as described above is accepted by me and is generally accepted by professional surveyors as the best available evidence of the witness corner.

C. Description of monument for corner and accessories established to perpetuate locating the position of the corner:
 Set Harrison Monument with witness cap at the location described above.
 Nail & KC Remon. tag W. side 12" Oak S00°W 7.26'
 Nail & KC Remon. tag E. side 12" Oak N00°E 18.38'
 Nail & KC Remon. tag SW side 10" Oak S40°E 24.85'
 Nail & KC Remon. tag N. side 8" Oak N70°E 29.56'

P.A. 345 1990 KENT COUNTY
 PEER APPROVED 8/28/97
 CHAIRMAN Harry Huber

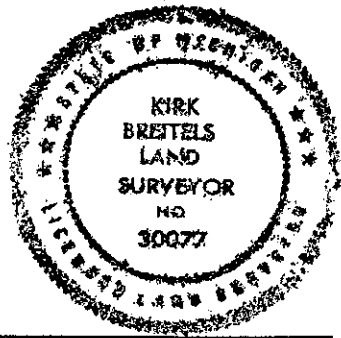

Signed by Kirk Breitels
 Surveyor's Michigan License No. 30077

Date 10/30/97