SURVEY & REMONUMENTATION

MAR 2 3 1998

KENT COUNTY REMONUMENTATION

SECTION

LAND CORNER RECORDATION CERTIFICATE
Filing Requirement of Act 74, Mich. P.A. 1970

STATE OF MICHIGAN
COUNTY OF KENT
RECEIVED FOR RECORD
97 OCT 14 AM 10:01
REG. OF DEEDS

For corners in KENT COUNTY (County)

Located In: Corner Code #

1. Public Land Survey		T 6N R 9W	M-8
		T R	
		T R	
		T R	Reg. #2
2. Property Controlling	S	T R	
in Section	S	T R	
3. Miscellaneous	S	T R	
Property in Sec.	S	T R	

10046
Register of Deeds Stamp & File Number

4. Lot No. _____, Recorded Plat _____
5. Private Claims _____

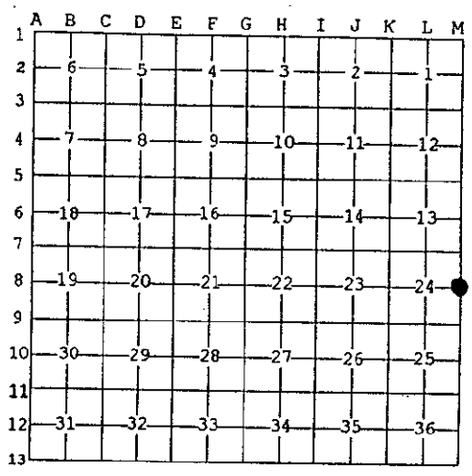

I, Kirk Breitels, in a field survey on Aug. 15, 19 97 do hereby state that under requirements of P.A. 74, Michigan P.A. of 1970, the corner points mentioned in lines 1 and 2 above were in conformance with regulations and rules therefore as required in the current manual of survey instructions of the United States Department of the Interior, Bureau of Land Management or by a decree of a Court of Law and /or that the corner points mentioned in lines 3, 4 and 5 above were in conformance with the rules of the Michigan Board of Land Surveyors or by a Decree of a Court of Law; established, re-established, monumented, recovered, found as expressed below:

NOTE: Not more than 2 corners, all in the same town and range, may be recorded on this certificate.

A. Description of original monument and accessories and/or subsequent restoration:

M-8	1830	GLO	Mullett	Set Post
	1993	LCRC #6967	Rosema	Set Kent County Witness Monument 193.00' North of corner (corner now in pond). Corner established at midpoint of straight line between M-7 and M-9.

The position of this corner was previously approved by the Kent County Remonumentation Peer Group, monumented by Maurice J. Rosema on 8/17/93 and was recorded per LCRC #6967.

B. Description of corner evidence found and/or method applied in restoring or reestablishing corner:

M-8 Found standard Kent Co. Witness Mon. (Harrison) per witnesses from above LCRC as set by Maurice J. Rosema. On June 26, 1997 the Kent Co. Remon. Peer Group approved a new location of M-9 based on further evidence. Since M-8 was established at the mid-point of a straight line between M-7 and M-9, the peer group approved the relocation of M-8 corresponding to the new location of M-9. Since the new location of M-8 is still in the pond, the witness monument per LCRC #6967 still retains its position with only it's offset to M-8 (by GPS and traverse) changing to 199.45' North of M-8.

The selected location is accepted by me and is generally accepted by professional surveyors as the best available evidence of the position of the original corner.

C. Description of monument for corner and accessories established to perpetuate locating the position of the corner:

M-8 Standard Kent County Witness Monument 199.45' North of M-8

Nail & KC Remon. tag S. side Tw. 8" Oak	N80°W	10.59'
Nail & KC Remon. tag NE side T. Pole	N15°W	50.73'
Nail & KC Remon. tag NE side 10" Ash	N05°E	114.21'
Nail & KC Remon. tag N. side 15" Maple	S25°E	44.60'
E. edge of E. rail of railroad track	N60°W	10.59'
M-7 (Kent Co. Mon.) - North 2447.36'		
M-9 (Kent Co. Mon.) - South 2846.26'		

STATE OF MICHIGAN
KIRK BREITELS
LAND SURVEYOR
NO 30077

Signed by Kirk Breitels Date 8/28/97

Surveyor's Michigan License No. 30077

P.A. 345 1990 KENT COUNTY
PEER APPROVED 6/26/97
CHAIRMAN

FORM APPROVED BY MICHIGAN STATE BOARD OF PROFESSIONAL SURVEYORS, JAN. 28, 1971
REVISED MAY 14,1975
REVISED JAN., 1983
REVISED OCT., 1995