

SURVEY & REMONUMENTATION

APR 27 1995

COMMISSION

KENT COUNTY REMONUMENTATION

LAND CORNER RECORDATION CERTIFICATE
Filing Requirement of Act 74, Mich. P.A. 1970

STATE OF MICHIGAN
COUNTY OF KENT
RECEIVED FOR RECORD
94 DEC -5 AM 9:00

W. R. Byl
REG. OF DEEDS

For corners in
KENT COUNTY

Located In:

Corner Code -#

- 1. Public Land Survey T 6N R 11W
T 6N R 10W
T 7N R 11W
T 7N R 10W
- 2. Property Controlling S _____ T _____ R _____
in Section S _____ T _____ R _____
- 3. Miscellaneous S _____ T _____ R _____
Property in Sec. S _____ T _____ R _____

- M-1
- A-1
- M-13
- A-13

7710

Register of Deeds Stamp & File Number

- 4. Lot No. _____, Recorded Plat _____
- 5. Private Claims _____

	A	B	C	D	E	F	G	H	I	J	K	L	M
2	6	5	4	3	2	1							
3													
4	7	8	9	10	11	12							
5													
6	18	17	16	15	14	13							
7													
8	19	20	21	22	23	24							
9													
10	30	29	28	27	26	25							
11													
12	31	32	33	34	35	36							
13													

I, William R. Byl, in a field survey on July 7, 19 94

do hereby certify that under requirements of P.A. 74, Michigan P.A. of 1970, the corner points mentioned in lines 1 and 2 above were in conformance with regulations and rules therefore as required in the current manual of survey instructions of the United States Department of the Interior, Bureau of Land Management or by a decree of a Court of Law and/or that the corner points mentioned in lines 3, 4 and 5 above were in conformance with the rules of the Michigan Board of Land Surveyors or by a Decree of a Court of Law; established, re-established, monumented, re-monumented, recovered, found as expressed below:

NOTE: Not more than 4 corners, all in the same town and range, may be recorded on this certificate.

A. Description of original monument and accessories and/or subsequent restoration:

M-1 1831 GLO Mullett Set Post
1966 Kent Co. Wit. 5/8" Solid Iron
1984 LCRC #3862 Rosema Set Kent County Monument
1991 LCRC #6419 Marschall Kent County Monument

P.A. 345 1990 KENT COUNTY

PEER APPROVED 12/1/99
CHAIRMAN W. R. Byl

The position of this corner was previously approved by the Kent County Remonumentation Peer Group, monumented by Maurice J. Rosema on 7/11/84 and was recorded per LCRC #3862.

B. Description of corner evidence found and/or method applied in restoring or reestablishing corner:


M-1 Found standard Kent Co. Mon. (Harrison) per witnesses from above LCRC as set by Maurice J. Rosema in place of the 1/2" Iron he found. Said Iron checks with plats to SW and NW of corner. All Kent Co. Wit. gone.

LCRC #3862 LCRC #6419
Nail & tag 6" Hickory N14°E 59.59' Nail & tag N. side 10" Apple N43°W 47.26'
SE cor. brick chimney N68°W 108.00' Nail & tag E. side 6" Oak N15°E 59.54'
Nail & tag 18" Hickory S02°E 172.77' Nail & tag SE side 10" Elm N27°E 75.86'
NE cor. garage (brick) S48°W 99.33' Top centerline hydrant N50°E 67.25'
Nail & tag 20" Oak N78°E 147.90' Nail & tag SW side P. Pole S46°E 70.18'
On C/L E-W B.T. road
C/L B.T. road to N. is W. 4'

The selected location is accepted by me and is generally accepted by professional surveyors as the best available evidence of the position of the original corner.

C. Description of monument for corner and accessories established to perpetuate locating the position of the corner:

M-1 Standard Kent County Monument
Nail & KC Remon. tag N. side 10" Apple N43°W 47.34'
Nail & KC Remon. tag SE side 10" Elm N27°E 76.05'
Top centerline hydrant N50°E 67.29'
Nail & KC Remon. tag SW side P. Pole (moved) S45°E 83.14'
On C/L E-W B.T. road
C/L B.T. road to N. is W. 4'

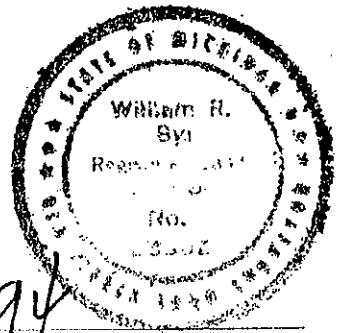

Signed by W. R. Byl
Surveyor's Michigan License No. 23502

Date 12/1/99