

SURVEY & REMONUMENTATION

FEB 14 1997

KENT COUNTY REMONUMENTATION

COMMISSION

LAND CORNER RECORDATION CERTIFICATE
Filing Requirement of Act 74, Mich. P.A. 1970

For corners in
KENT COUNTY
(County)

Located In:	Corner Code #
1. Public Land Survey T 6N R 10W	A-3
T R	
T R	
T R	
2. Property Controlling in Section S T R	
S T R	
3. Miscellaneous Property in Sec. S T R	
S T R	

STATE OF MICHIGAN
COUNTY OF KENT
RECEIVED FOR RECORD

96 JUN -7 AM 8:26

REG. OF DEEDS

Lucy Bond

9144

Register of Deeds Stamp & File Number

4. Lot No. _____, Recorded Plat _____
5. Private Claims _____

I, Kirk Breitels, in a field survey on Apr. 5, 1996 do hereby state that under requirements of P.A. 74, Michigan P.A. of 1970, the corner points mentioned in lines 1 and 2 above were in conformance with regulations and rules therefore as required in the current manual of survey instructions of the United States Department of the Interior, Bureau of Land Management or by a decree of a Court of Law and /or that the corner points mentioned in lines 3, 4 and 5 above were in conformance with the rules of the Michigan Board of Land Surveyors or by a Decree of a Court of Law; established, re-established, monumented, recovered, found as expressed below:

A	B	C	D	E	F	G	H	I	J	K	L	M
1												
2	6		5		4		3		2		1	
3												
4	7		8		9		10		11		12	
5												
6	18		17		16		15		14		13	
7												
8	19		20		21		22		23		24	
9												
10	30		29		28		27		26		25	
11												
12	31		32		33		34		35		36	
13												

NOTE: Not more than 2 corners, all in the same town and range, may be recorded on this certificate.

A. Description of original monument and accessories and/or subsequent restoration:

A-3	1831	GLO	Mullett	Set Post Monument
	1964	Kent Co. Wit.		
	1969	Williams & Works		Steel fence post
	1984	LCRC #3969	Rosema	Set Kent County Monument
	1989	LCRC #4993	Bueche	Kent County Monument

P.A. 345 1990 KENT COUNTY
PEER APPROVED 5/30/96
CHAIRMAN Harry Huber

The position of this corner was previously approved by the Kent County Remonumentation Peer Group, monumented by Maurice J. Rosema on 8/24/84 and was recorded per LCRC #3969

B. Description of corner evidence found and/or method applied in restoring or reestablishing corner:

A-3 Found standard Kent Co. Mon. (Harrison) per witnesses from above LCRC as set by Maurice J. Rosema on Twp. Line in place of the Steel Fence Post he found. Said Fence Post checks with Kent Co. Wit. and Williams & Works information


LCRC #3969	LCRC #4993 (Nail/tag in trees)
Nail/tag 15" Elm N48°E 19.64'	16" Elm S60°E 54.46'
Nail/tag 12" Elm S89°W 21.85'	10" Elm S85°E 43.60'
Nail/tag 10" Elm S33°W 38.23'	14" Elm N40°E 65.03'
Nail/tag 8" Boxelder S57°E 10.70'	18" Elm N15°E 103.90'
KC Mon. (M-3, 6-11) South 83.08'	14" Elm S89°W 21.85'
	12" Elm S33°W 38.23'
	KC Mon. (M-3, 6-11) South 83.08'

The selected location is accepted by me and is generally accepted by professional surveyors as the best available evidence of the position of the original corner.

C. Description of monument for corner and accessories established to perpetuate locating the position of the corner.

A-3 Standard Kent County Monument

New Nail & KC Remon. tag S. side 24" Elm	S60°E 54.64'
Nail & KC Remon. tag S. side 10" dead Elm	S85°E 43.75'
New Nail & KC Remon. tag W. side 18" Elm	N40°E 65.03'
Set Nail & KC Remon. tag S. side 10" Elm	S65°W 36.02'
Set Nail & KC Remon. tag N. side 10" Boxelder	N75°W 47.10'
C/L Manhole	S45°W 58.52'
Kent Co. Mon. (M-3, T6N, R11W)	South 83.08'
Mon. at E. edge of large ditch	

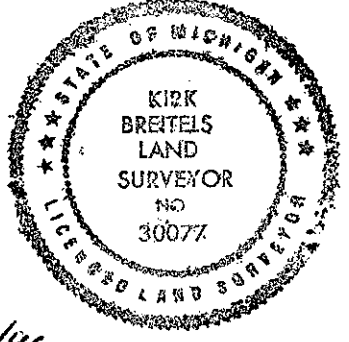

Signed by *Kirk Breitels*
Surveyor's Michigan License No. 30077

Date 4/19/96