SURVEY & REMONUMENTATION

FEB 14 1997

COMMISSION

KENT COUNTY REMONUMENTATION

LAND CORNER RECORDATION CERTIFICATE
Filing Requirement of Act 74, Mich. P.A. 1970

STATE OF MICHIGAN COUNTY OF KENT RECEIVED FOR RECORD 96 MAR 20 AM 8:44

REG. OF DEEDS

8929

Register of Deeds Stamp & File Number

For corners in KENT COUNTY (County)

	Located In:	Corner Code #
1. Public Land Survey	T 6N R 10W	A-5
	T___ R___	
	T___ R___	
	T___ R___	
2. Property Controlling in Section	S___ T___ R___	
	S___ T___ R___	
3. Miscellaneous Property in Sec.	S___ T___ R___	
	S___ T___ R___	

4. Lot No. _____, Recorded Plat _____

5. Private Claims _____

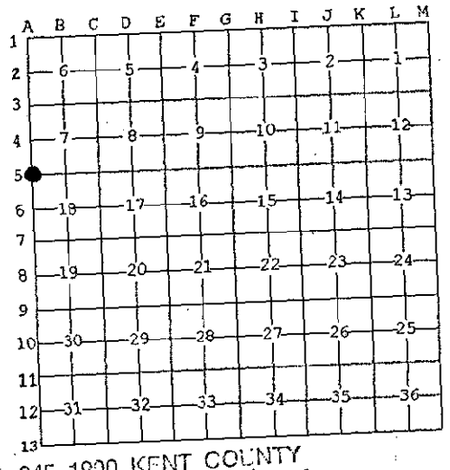

I, Kirk Breitels, in a field survey on Feb. 26, 19 96 do hereby state that under requirements of P.A. 74, Michigan P.A. of 1970, the corner points mentioned in lines 1 and 2 above were in conformance with regulations and rules therefore as required in the current manual of survey instructions of the United States Department of the Interior, Bureau of Land Management or by a decree of a Court of Law and /or that the corner points mentioned in lines 3, 4 and 5 above were in conformance with the rules of the Michigan Board of Land Surveyors or by a Decree of a Court of Law; established, re-established, monumented, recovered, found as expressed below:

NOTE: Not more than 2 corners, all in the same town and range, may be recorded on this certificate.

P.A. 345 1990 KENT COUNTY
PEER APPROVED 3/7/96
CHAIRMAN Harry Huber

A. Description of original monument and accessories and/or subsequent restoration:

A-5	1831	GLO	Mullett	Set Post
	1962	Kent Co. Wit.		Iron
	1972	LCRC #145	N.C. Jones	1" Iron in Mon. Box
	1984	LCRC #4102	Rosema	Set Kent County Monument in Mon. Box
	1989	LCRC #4995	Bueche	Kent County Monument in Mon. Box

The position of this corner was previously approved by the Kent County Remonumentation Peer Group, monumented by Maurice J. Rosema on 7/25/84 and was recorded per LCRC #4102

B. Description of corner evidence found and/or method applied in restoring or reestablishing corner:

A-5 Found standard Kent Co. Mon. (Harrison) per witnesses from above LCRC as set by Maurice J. Rosema on Twp. line in place of the 3/4" Iron he found inside a Mon. Box. Said Iron checks with Kent Co. Wit. and LCRC #145.

LCRC #4102			LCRC #4995		
Nail/tag curb joint	S65°E	57.37'	Nail/tag P. Pole	N31°E	89.64'
Nail/tag P. Pole	S37°W	101.62'	Nail/tag P. Pole	S65°E	117.55'
Nail/tag P. Pole	N31°E	89.64'	Nail/tag P. Pole	N40°W	86.54'
Nail/tag P. Pole	N26°W	71.53'	SE cor. CB	S60°W	78.23'
KC Mon. (B-5)	East	2517.05'			

The selected location is accepted by me and is generally accepted by professional surveyors as the best available evidence of the position of the original corner.

C. Description of monument for corner and accessories established to perpetuate locating the position of the corner:

A-5 Standard Kent County Monument in Mon. Box		
Nail & KC Remon. tag N. side P. Pole	S65°E	117.63'
SE corner catch basin header	S60°W	79.97'
C/L top of fire hydrant	S65°W	108.53'
Set Nail & KC Remon. tag E. side P. Pole	N30°E	94.95'
Set Nail & KC Remon. tag NE side P. Pole	N40°W	109.14'
NE corner catch basin header	N60°W	86.95'
Kent Co. Mon. (M-5, T6N, R11W)	North	10.53'

STATE OF MICHIGAN KIRK BREITELS LAND SURVEYOR NO. 30077 LICENSED LAND SURVEYOR

Signed by Kirk Breitels Date 3/1/96

Surveyor's Michigan License No. 30077

FORM APPROVED BY MICHIGAN STATE BOARD OF PROFESSIONAL SURVEYORS, JAN. 28, 1971
REVISED MAY 14,1975
REVISED JAN., 1983
REVISED OCT., 1995