SURVEY & REMONUMENTATION

SEP 18 1995

$7.00 / $2.00 COMMISSION

KENT COUNTY REMONUMENTATION

STATE OF MICHIGAN
COUNTY OF KENT
RECEIVED FOR RECORD
95 MAY 12 AM 10: 43

REG. OF DEEDS

8348

Register of Deeds Stamp & File Number

LAND CORNER RECORDATION CERTIFICATE

Filing Requirement of Act 74, Mich. P.A. 1970

For corners in KENT COUNTY (County)

	Located In:	Corner Code ##
1. Public Land Survey	T 6N R 10W	A-10
	T ___ R ___	
	T ___ R ___	
	T ___ R ___	
2. Property Controlling	S ___ T ___ R ___	
in Section	S ___ T ___ R ___	
3. Miscellaneous	S ___ T ___ R ___	
Property in Sec.	S ___ T ___ R ___	

4. Lot No. _____, Recorded Plat _____
5. Private Claims _____

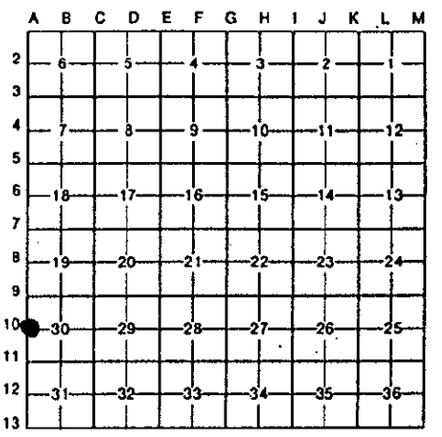

I, Kirk Breitels, in a field survey on March 23, 19 95, do hereby certify that under requirements of P.A. 74, Michigan P.A. of 1970, the corner points mentioned in lines 1 and 2 above were in conformance with regulations and rules therefore as required in the current manual of survey instructions of the United States Department of the Interior, Bureau of Land Management or by a decree of a Court of Law and/or that the corner points mentioned in lines 3, 4 and 5 above were in conformance with the rules of the Michigan Board of Land Surveyors or by a Decree of a Court of Law; established, re-established, monumented, re-monumented, recovered, found as expressed below:

NOTE: Not more than 4 corners, all in the same town and range, may be recorded on this certificate.

A. Description of original monument and accessories and/or subsequent restoration:

A-10	1831	GLO	Mullett	Not Set
	1972	LCRC #107	Bonnema	Set RR Spike 5.61' N of M-10 Paris
	1980	LCRC #1440	Merdzinski	Set Kent co. Mon.
	1989	LCRC #4999	Bueche	Kent Co. Mon.
	1993	LCRC #6762	Roon	Kent Co. Mon.

P.A. 345 1990 KENT COUNTY
PEER APPROVED 3/30/95
CHAIRMAN Gary Huber

The position of this corner was previously approved by the Kent County Remonumentation Peer Group, monumented by John A. Merdzinski on 10/22/80 and was recorded per LCRC #1440

B. Description of corner evidence found and/or method applied in restoring or reestablishing corner:

A-10 Found PK Nail (road const. 1994) at the same location as Kent Co. Mon. as set in 1980 by John A. Merdzinski in place of the RR spike he found. Said RR spike fit LCRC #107. Said PK Nail fits prev. survey data prior to construction and remaining witnesses of LCRC's #1440, #4999, #6762. Found remains of Kent Co. Mon. 24" below road grade.

LCRC #1440			LCRC #4999		
Nail & tag Dbl. 4" Box Elder	N45°W	58.67'	Top C/L Hydrant	N60°W	30.70'
Nail & tag 6" Elm	N86°E	55.33'	NW cor. conc. base MBT box	S45°E	64.66'
Top C/L Hydrant	N60°W	30.70'	NE cor. conc. base Lt. tower	S52°W	98.46'
NW cor. conc. base MBT box	S45°E	64.66'	"T" Iron South (C/L E-W runway)		62.05'
NE cor. conc. base Lt. tower	S52°W	98.46'	Top C/L Steel Post	S70°W	46.55'
"T" Iron South (C/L E-W runway)		62.05'	Face of S. gate post	S70°W	70.10'
Top C/L Steel Post	S70°W	46.55'	KC Mon. (M-10, T6N, R11W)	South	5.63'

The selected position is accepted by me and is generally accepted by professional surveyors as the best available evidence of the original corner.

C. Description of monument for corner and accessories established to perpetuate locating the position of the corner:

A-10 Set Standard Kent County Monument (Harrison) in place of the PK Nail over remains of original Kent Co. Mon.

Top C/L Fire Hydrant	N60°W	41.44'
KC Mon. (A-10, T6N, R10W)	S00°E	5.64'
NW cor. Elec. Box (4' High)	S45°E	59.27'
Face of North gate post	S85°W	54.88'
Face of South gate post	S70°W	57.84'
On C/L N-S B.T.		

STATE OF MICHIGAN
KIRK BREITELS
LAND SURVEYOR
NO 30077
LICENSED LAND SURVEYOR

Signed by Kirk Breitels Date 3/30/95

Surveyor's Michigan License No. 30077

FORM APPROVED BY MICHIGAN STATE BOARD OF LAND SURVEYORS, JAN. 28, 1971
REVISED MAY 14, 1975
REVISED JAN., 1983