

REMONUMENTATION

FEB 14 1997

COMMISSION

KENT COUNTY REMONUMENTATION

LAND CORNER RECORDATION CERTIFICATE
Filing Requirement of Act 74, Mich. P.A. 1970

For corners in
KENT COUNTY

(County)

Located In: Corner Code #

| | | |
|------------------------------------|-------------------------|-------|
| 1. Public Land Survey | T 6N R 10W | B-6 |
| | T _____ R _____ | _____ |
| | T _____ R _____ | _____ |
| | T _____ R _____ | _____ |
| 2. Property Controlling In Section | S _____ T _____ R _____ | _____ |
| | S _____ T _____ R _____ | _____ |
| 3. Miscellaneous Property in Sec. | S _____ T _____ R _____ | _____ |
| | S _____ T _____ R _____ | _____ |

REG. OF DEEDS

Lucy Bond

STATE OF MICHIGAN
COUNTY OF KENT
RECEIVED FOR RECORD
96 SEP 13 PM 12:06

9374

Register of Deeds Stamp & File Number

4. Lot No. _____, Recorded Plat _____
5. Private Claims _____

I, Kirk Breitels, in a field survey on July 29, 1996 do hereby state that under requirements of P.A. 74, Michigan P.A. of 1970, the corner points mentioned in lines 1 and 2 above were in conformance with regulations and rules therefore as required in the current manual of survey instructions of the United States Department of the Interior, Bureau of Land Management or by a decree of a Court of Law and /or that the corner points mentioned in lines 3, 4 and 5 above were in conformance with the rules of the Michigan Board of Land Surveyors or by a Decree of a Court of Law; established, re-established, monumented, recovered, found as expressed below:

NOTE: Not more than 2 corners, all in the same town and range, may be recorded on this certificate.

| | | | | | | | | | | | | | |
|----|----|---|----|---|----|---|----|---|----|---|----|---|---|
| | A | B | C | D | E | F | G | H | I | J | K | L | M |
| 1 | | | | | | | | | | | | | |
| 2 | 6 | | 5 | | 4 | | 3 | | 2 | | 1 | | |
| 3 | | | | | | | | | | | | | |
| 4 | 7 | | 8 | | 9 | | 10 | | 11 | | 12 | | |
| 5 | | | | | | | | | | | | | |
| 6 | 10 | | 17 | | 16 | | 15 | | 14 | | 13 | | |
| 7 | | | | | | | | | | | | | |
| 8 | 19 | | 20 | | 21 | | 22 | | 23 | | 24 | | |
| 9 | | | | | | | | | | | | | |
| 10 | 30 | | 29 | | 28 | | 27 | | 26 | | 25 | | |
| 11 | | | | | | | | | | | | | |
| 12 | 31 | | 32 | | 33 | | 34 | | 35 | | 36 | | |
| 13 | | | | | | | | | | | | | |

A. Description of original monument and accessories and/or subsequent restoration:

- B-6 1831---GLO---Not Set
- 1949-67---Williams & Works---Set/Used Iron on E-W 1/4 and line btw. N 1/4 and fence corner at S 1/4 cor.
- 1977---LCRC #1037---Merdzinski---3/4" Iron Pipe
- 16" Oak NE 24.66' 28" Oak NNE 9.74' P. Pole W 47.32'
- 1985---"Foremost Ind. Park No. 2"---Conc. Monument symbol at Center of Sec.
- 1990---Survey---Exxel Eng.---Conc. Monument
- NW cor. bldg. S13°E 184.06' NE cor. bldg. S54°E 307.11'
- PK in P. Pole S84°W 48.63' San MH N51°E 27.47'

B. Description of corner evidence found and/or method applied in restoring or reestablishing corner:


B-6 Found Concrete Monument per the following witnesses: P.A. 345 1990 KENT COUNTY
 NW cor. bldg. S13°E 184.11' (EDM) PEER APPROVED 7/25/96
 PK in P. Pole S84°W 48.65' (EDM) CHAIRMAN *Henry Huber*

Said Concrete Monument is 0.3' E and 0.8' N. from intersection of 1/4 lines and agrees with adjoining plats and survey measurements of others.

The Concrete Monument is accepted by me and is generally accepted by professional surveyors as the best available evidence of the position of the corner.

C. Description of monument for corner and accessories established to perpetuate locating the position of the corner:

- B-6 Set Standard Kent County Monument in place of the Concrete Monument
- NW corner foundation of conc. block bldg. S13°E 184.11'
- PK Nail S. side Power Pole S84°W 48.65'
- NW corner conc. block bldg. (new addition) S52°E 127.70'
- NW corner catch basin casting S85°E 364.16'
- C/L Manhole N15°E 375.15'
- C/L Manhole N85°E 379.49'
- C/L of 2 track trail (curve) is NE 57'±

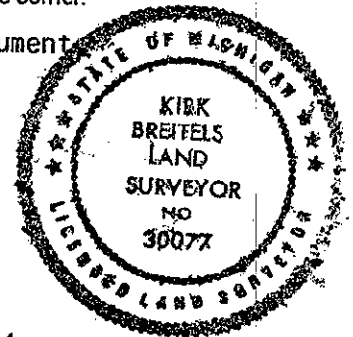

Signed by *Kirk Breitels*

Date 8/25/96

Surveyor's Michigan License No. 30077