

**SURVEY & REMONUMENTATION**

FEB 14 1997

**KENT COUNTY REMONUMENTATION**

COMMISSION

**LAND CORNER RECORDATION CERTIFICATE**  
Filing Requirement of Act 74, Mich. P.A. 1970

For corners in  
**KENT COUNTY**

Located In:	Corner Code #
T 6N R 10W	<u>B-13</u>
T 5N R 10W	<u>B-1</u>
T _____ R _____	_____
T _____ R _____	_____
S _____ T _____ R _____	_____
S _____ T _____ R _____	_____
S _____ T _____ R _____	_____
S _____ T _____ R _____	_____

STATE OF MICHIGAN  
COUNTY OF KENT  
RECEIVED FOR RECORD

96 JUN -7 AM 8:26

REG. OF DEEDS

*Lucy Sp...d*

**9146**

Register of Deeds Stamp & File Number

- 1. Public Land Survey
- 2. Property Controlling in Section
- 3. Miscellaneous Property in Sec.
- 4. Lot No. \_\_\_\_\_, Recorded Plat \_\_\_\_\_
- 5. Private Claims \_\_\_\_\_

I, Kirk Breitels, in a field survey on Apr. 3, 19 96 do hereby state that under requirements of P.A. 74, Michigan P.A. of 1970, the corner points mentioned in lines 1 and 2 above were in conformance with regulations and rules therefore as required in the current manual of survey instructions of the United States Department of the Interior, Bureau of Land Management or by a decree of a Court of Law and/or that the corner points mentioned in lines 3, 4 and 5 above were in conformance with the rules of the Michigan Board of Land Surveyors or by a Decree of a Court of Law; established, re-established, monumented, recovered, found as expressed below:

NOTE: Not more than 2 corners, all in the same town and range, may be recorded on this certificate.

	A	B	C	D	E	F	G	H	I	J	K	L	M
1													
2		6		5		4		3		2		1	
3													
4		7		8		9		10		11		12	
5													
6		18		17		16		15		14		13	
7													
8		19		20		21		22		23		24	
9													
10		30		29		28		27		26		25	
11													
12		31		32		33		34		35		36	
13													

A. Description of original monument and accessories and/or subsequent restoration:

B-13	1831	GLO	Mullett	Set Post
	1957-66	Williams & Works		Iron
	1984	LCRC #3816	Chettleburgh	Set Kent County Monument
	1984	Kent County Peer Group held B-13, 6-10 common with B-1, 5-10		
	1993	LCRC #6766	Roon	Kent County Monument
	1994	LCRC #7081	Bueche	Kent County Monument

P.A. 345 1990 KENT COUNTY

PEER APPROVED 5/30/96  
CHAIRMAN *Harry Bueche*

The position of this corner was previously approved by the Kent County Remonumentation Peer Group, monumented by Thomas Chettleburgh on 12/28/83 and recorded per LCRC #3816

B. Description of corner evidence found and/or method applied in restoring or reestablishing corner:


B-13 Found standard Kent Co. Mon. (Harrison) per witnesses from above LCRC as set by Thomas Chettleburgh in place of the 1 1/4" Iron Pipe over a 1 1/2" Iron Pipe he found. Both Irons check with Kent Co. Wit. and information of others.

<u>LCRC #3816 &amp; #7081</u>	<u>LCRC #6766</u>			
Nail/tag Guy Pole	N83°E 179.34'	Nail in 8" Pine	S72°E 106.39'	
Nail/tag 10" Pine	S72°E 106.24'	Nail in P. Pole	S82°W 175.62'	
C/L S. end culv.	S11°W 19.56'	Guard Post	South 17.20'	
PK Nail P. Pole	S82°W 175.45'	Guard Post	North 20.17'	
C/L N. end culv.	N07°W 23.72'			

The selected location is accepted by me and is generally accepted by professional surveyors as the best available evidence of the position of the original corner.

C. Description of monument for corner and accessories established to perpetuate locating the position of the corner:

B-13 Standard Kent County Monument			
Nail & KC Remon. tag S. side Guy Pole	N83°E	179.38'	
Nail & KC Remon. tag NE side 10" Pine	S72°E	106.24'	
C/L S. end 12" conc. culv.	S11°W	19.73'	
PK Nail in N. side P. Pole	S82°W	175.51'	
C/L N. end 12" conc. culv.	N07°W	23.90'	
150'± W. of hse. #5240 60th St.			
On C/L bit. E-W			

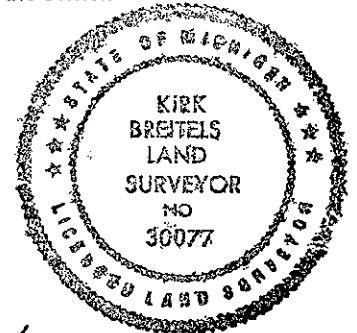

Signed by *Kirk Breitels*  
Surveyor's Michigan License No. 30077

Date 4/19/96