

SURVEY & REMONUMENTATION

FEB 14 1997

KENT COUNTY REMONUMENTATION

COMMISSION LAND CORNER RECORDATION CERTIFICATE
Filing Requirement of Act 74, Mich. P.A. 1970

STATE OF MICHIGAN
COUNTY OF KENT
RECEIVED FOR RECORD
96 MAR 20 AM 8:44
REG. OF DEEDS
Lucy Bond


For corners in
KENT COUNTY
(County)

Located In:	Corner Code #
1. Public Land Survey	T 6N R 10W C-2
2. Property Controlling in Section	T R
3. Miscellaneous Property in Sec.	T R
	T R
	T R
	T R
	T R
	T R
	T R

4. Lot No. _____, Recorded Plat _____
5. Private Claims _____

8937

Register of Deeds Stamp & File Number

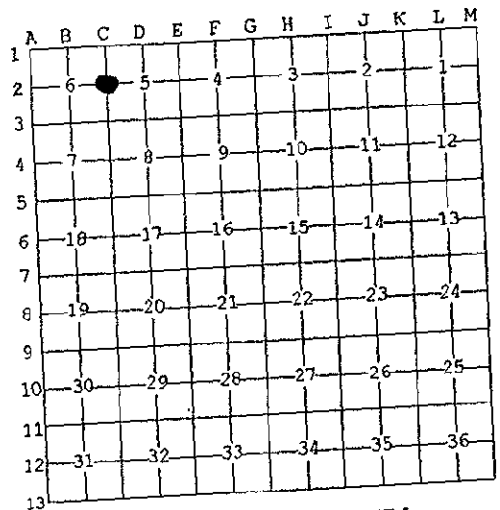

I, Kirk Breitels, in a field survey on Feb. 5, 1996 do hereby state that under requirements of P.A. 74, Michigan P.A. of 1970, the corner points mentioned in lines 1 and 2 above were in conformance with regulations and rules therefore as required in the current manual of survey instructions of the United States Department of the Interior, Bureau of Land Management or by a decree of a Court of Law and/or that the corner points mentioned in lines 3, 4 and 5 above were in conformance with the rules of the Michigan Board of Land Surveyors or by a Decree of a Court of Law; established, re-established, monumented, recovered, found as expressed below:

NOTE: Not more than 2 corners, all in the same town and range, may be recorded on this certificate.

A. Description of original monument and accessories and/or subsequent restoration:

C-2	1831	GLO	Mullett	Set Post
	1965	Kent Co. Wit.		Plat Monument
	1975	LCRC #851	Nederveld	Plat Monument
	1982	LCRC #2729	Merdzinski	Set Kent County Monument
	1994	LCRC #7091	Bueche	Kent County Monument

P.A. 345 1990 KENT COUNTY
PEER APPROVED 3/17/96
CHAIRMAN *Harry Huber*

The position of this corner was previously approved by the Kent County Remonumentation Peer Group, monumented by John A. Merdzinski on 2/3/82 and was recorded per LCRC #2729

B. Description of corner evidence found and/or method applied in restoring or reestablishing corner:

C-2 Found standard Kent Co. Mon. (Harrison) per witnesses from above LCRC as set by John A. Merdzinski in place of the Concrete Monument he found. Said Concrete Monument checks with Kent Co. Wit. and LCRC #851.

LCRC #2729		LCRC #7091	
Nail/tag 12" Oak	South 72.05'	Nail/tag 18" Oak	South 72.04'
Nail/tag 8" Elm	S55°E 13.91'	SE cor. storage bldg.	N35°W 191.20'
Nail/tag 8" Elm	N15°E 9.50'	SW cor. brick bldg.	N35°E 274.3'
SE cor. bldg.	N35°W 191.20'	Face of fence cor.	N70°W 210.10'
SW cor. bldg.	N35°E 274.3'		

The selected location is accepted by me and is generally accepted by professional surveyors as the best available evidence of the position of the original corner.

C. Description of monument for corner and accessories established to perpetuate locating the position of the corner:

C-2 Standard Kent County Monument	South	72.04'
Nail & KC Remon. tag W. side 20" Oak	N35°W	191.20'
SE corner frame storage bldg.	N45°W	174.55'
SW corner frame shed	N70°W	209.95'
Face of chain link fence post (fc. South)	S65°W	195.95'
NE corner frame storage bldg.	N35°E	274.3'
SW'ly corner brick bldg.		



Signed by *Kirk Breitels*
Surveyor's Michigan License No. 30077

Date 3/1/96