

**SURVEY & REMONUMENTATION**

**KENT COUNTY REMONUMENTATION**

FEB 14 1997

**LAND CORNER RECORDATION CERTIFICATE**  
Filing Requirement of Act 74, Mich. P.A. 1970

For corners in  
**KENT COUNTY**  
(County)

**COMMISSION**

Located In: Corner Code #

- |                                    |            |     |
|------------------------------------|------------|-----|
| 1. Public Land Survey              | T 6N R 10W | C-3 |
|                                    | T R        |     |
|                                    | T R        |     |
|                                    | T R        |     |
| 2. Property Controlling in Section | S T R      |     |
|                                    | S T R      |     |
| 3. Miscellaneous Property in Sec.  | S T R      |     |
|                                    | S T R      |     |

REG. OF DEEDS

*Handwritten signature*

96 MAR 20 AM 8:44

STATE OF MICHIGAN  
COUNTY OF KENT  
RECEIVED FOR RECORD


8938

Register of Deeds Stamp & File Number

4. Lot No. \_\_\_\_\_, Recorded Plat \_\_\_\_\_  
5. Private Claims \_\_\_\_\_

I, Kirk Breitels, in a field survey on Feb. 26, 19 96 do hereby state that under requirements of P.A. 74, Michigan P.A. of 1970, the corner points mentioned in lines 1 and 2 above were in conformance with regulations and rules therefore as required in the current manual of survey instructions of the United States Department of the Interior, Bureau of Land Management or by a decree of a Court of Law and/or that the corner points mentioned in lines 3, 4 and 5 above were in conformance with the rules of the Michigan Board of Land Surveyors or by a Decree of a Court of Law; established, re-established, monumented, recovered, found as expressed below:

NOTE: Not more than 2 corners, all in the same town and range, may be recorded on this certificate.

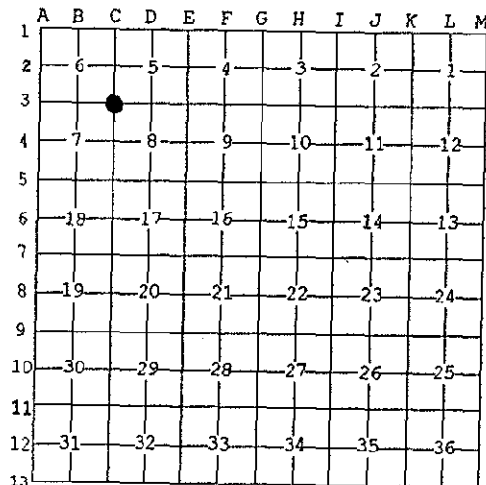

P.A. 345 1990 KENT COUNTY

PEER APPROVED 3/7/96  
CHAIRMAN Harry Huber

A. Description of original monument and accessories and/or subsequent restoration:

- |     |      |               |            |                          |
|-----|------|---------------|------------|--------------------------|
| C-3 | 1831 | GLO           | Mullett    | Set Post                 |
|     | 1978 | Kent Co. Wit. |            | Iron at fence cor.       |
|     | 1978 | LCRC #1192    | Stadt      | Concrete Monument        |
|     | 1979 | LCRC #1267    | Bonnema    | Concrete Monument        |
|     | 1981 | LCRC #1582    | Merdzinski | Set Kent County Monument |
|     | 1994 | LCRC #7092    | Bueche     | Kent County Monument     |

The position of this corner was previously approved by the Kent County Remonumentation Peer Group, monumented by John A. Merdzinski on 1/29/81 and was recorded per LCRC #1582

B. Description of corner evidence found and/or method applied in restoring or reestablishing corner:

C-3 Found standard Kent Co. Mon. (Harrison) per witnesses from above LCRC as set by John A. Merdzinski in place of the Concrete Monument he found. Said Concrete Monument checks with Kent Co. Wit. and LCRC's #1192, #1267.

LCRC #1582 (Nail/tag in trees)

- Group 6"-14" Maples N10°E 33.96'
- 8" Maple N30°E 18.44'
- Twin 18" Maple N70°E 26.88'
- 10" Maple S30°E 28.17'
- 8" Elm S30°W 19.10' 10" Oak S75°E 5.39'

LCRC #7092

- Nail/tag 10"-18" Maples N10°E 32.78'
- Nail/tag dbl. 24" Maple N70°E 26.78'
- Nail/tag 12" Oak S75°E 5.06'
- Nail/tag 4 6"-8" Trees N35°E 47.20'

The selected location is accepted by me and is generally accepted by professional surveyors as the best available evidence of the position of the original corner.

C. Description of monument for corner and accessories established to perpetuate locating the position of the corner:

C-3 Standard Kent County Monument

- Nail & KC Remon. tag W. side 10"-24" Maples N10°E 32.78'
- Nail & KC Remon. tag S. side dbl. 24" Maple N70°E 26.78'
- Nail & KC Remon. tag S. side 12" Oak S75°E 5.06'
- Nail & KC Remon. tag W. side 4 6"-8" Trees N35°E 47.23'



Signed by Kirk Breitels  
Surveyor's Michigan License No. 30077

Date 3/1/96