

SURVEY & REMONUMENTATION

FEB 14 1997

KENT COUNTY REMONUMENTATION

COMMISSION

LAND CORNER RECORDATION CERTIFICATE
Filing Requirement of Act 74, Mich. P.A. 1970

For corners in
KENT COUNTY
(County)

Located In:	Corner Code #
T 6N R 10W	C-5
T R	
T R	
T R	
S T R	
S T R	
S T R	
S T R	

1. Public Land Survey


2. Property Controlling in Section

3. Miscellaneous Property in Sec.

4. Lot No. _____, Recorded Plat _____
5. Private Claims _____

I, Kirk Breitels, in a field survey on Feb. 26, 1996 do hereby state that under requirements of P.A. 74, Michigan P.A. of 1970, the corner points mentioned in lines 1 and 2 above were in conformance with regulations and rules therefore as required in the current manual of survey instructions of the United States Department of the Interior, Bureau of Land Management or by a decree of a Court of Law and /or that the corner points mentioned in lines 3, 4 and 5 above were in conformance with the rules of the Michigan Board of Land Surveyors or by a Decree of a Court of Law, established, re-established, monumented, recovered, found as expressed below.

NOTE: Not more than 2 corners, all in the same town and range, may be recorded on this certificate.

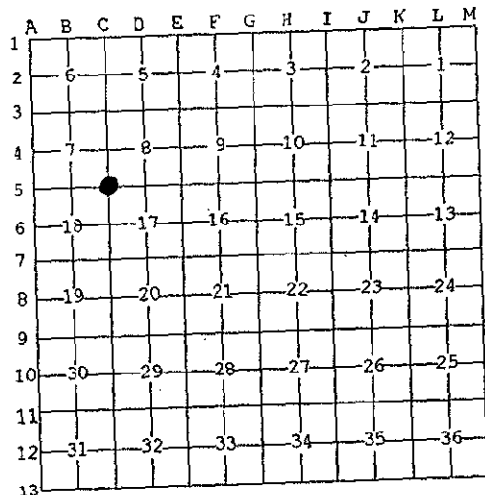

A. Description of original monument and accessories and/or subsequent restoration:

C-5	1831	GLO	Mullett	Set Post
	1972	LCRC #577	Spicer	3/4" Iron
	1973	LCRC #590	Bonnema	1/2" Iron in Mon. Box
	1982	LCRC #3104	Merdzinski	Set Kent County Monument in Mon. Box
	1994	LCRC #7094	Bueche	Kent County Monument in Mon. Box

P.A. 345 1990 KENT COUNTY

PEER APPROVED 2/7/96

The position of this corner was previously approved by the Kent County Remonumentation Peer Group, monumented by John A. Merdzinski on 10/12/82 and was recorded per LCRC #3104

B. Description of corner evidence found and/or method applied in restoring or reestablishing corner:

C-5 Found standard Kent Co. Mon. (Harrison) per witnesses from above LCRC as set by John A. Merdzinski in place of the 3/4" Iron he found inside a Mon. Box. Said Iron checks with LCRC's #577, #590.

LCRC #3104	LCRC #7094
Nail/tag P. Pole N45°E 66.00'	NE cor. conc. pad CP box S35°W 101.13'
Nail/tag P. Pole N40°W 64.70'	NW cor. CB casting S10°E 109.70'
Nail/tag G. Pole S30°E 90.50'	NE cor. metal base CP box N65°W 230.52'
Top C/L hydrant S45°E 100.25'	Nail/tag P. Pole N45°E 70.99'
	C/L top hydrant S45°E 99.59'

The selected location is accepted by me and is generally accepted by professional surveyors as the best available evidence of the position of the original corner.

C. Description of monument for corner and accessories established to perpetuate locating the position of the corner:

C-5 Standard Kent County Monument in Mon. Box	
NE corner conc. pad of CP box	S35°W 101.13'
NW corner catch basin casting	S10°E 109.70'
NE corner plastic base Tele. box	N65°W 230.52'
Nail & KC Remon. tag SE side P. Pole	N45°E 71.03'
C/L top of fire hydrant	S45°E 99.59'
C/L 28th St. is South 19'±	
On C/L Kraft Ave. N-S ±	



Signed by

Kirk Breitels

Date

3/1/96

Surveyor's Michigan License No.

30077