

SURVEY & REMONUMENTATION

FEB 14 1997

COMMISSION

KENT COUNTY REMONUMENTATION

LAND CORNER RECORDATION CERTIFICATE
Filing Requirement of Act 74, Mich. P.A. 1970

For corners in
KENT COUNTY

(County)

Located in:

Corner Code #

1. Public Land Survey	T <u>6N</u> R <u>10W</u>	<u>C-6</u>
	T <u> </u> R <u> </u>	<u> </u>
	T <u> </u> R <u> </u>	<u> </u>
	T <u> </u> R <u> </u>	<u> </u>
2. Property Controlling in Section	S <u> </u> T <u> </u> R <u> </u>	<u> </u>
	S <u> </u> T <u> </u> R <u> </u>	<u> </u>
3. Miscellaneous Property in Sec.	S <u> </u> T <u> </u> R <u> </u>	<u> </u>
	S <u> </u> T <u> </u> R <u> </u>	<u> </u>

REG. OF DEEDS

Handwritten signature

96 MAR 20 AM 8:41

STATE OF MICHIGAN
COUNTY OF KENT
RECEIVED FOR RECORD


8941

Register of Deeds Stamp & File Number

4. Lot No. _____, Recorded Plat _____
5. Private Claims _____

I, Kirk Breitels, in a field survey on Feb. 6 1996 do hereby state that under requirements of P.A. 74, Michigan P.A. of 1970, the corner points mentioned in lines 1 and 2 above were in conformance with regulations and rules therefore as required in the current manual of survey instructions of the United States Department of the Interior, Bureau of Land Management or by a decree of a Court of Law and for that the corner points mentioned in lines 3, 4 and 5 above were in conformance with the rules of the Michigan Board of Land Surveyors or by a Decree of a Court of Law; established, re-established, monumented, recovered, found as expressed below:

NOTE: Not more than 2 corners, all in the same town and range, may be recorded on this certificate.

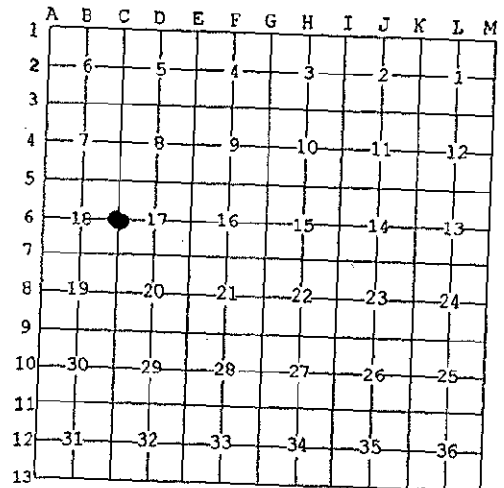

A. Description of original monument and accessories and/or subsequent restoration:

C-6	1831	GLO	Mullett	Set Post
	1959	Kent Co. Wit.		Iron in Mon. Box
	1973	LCRC #577	Spicer	3/4" Iron in Mon. Box
	1981	LCRC #1886	Merdzinski	Set Kent County Monument
	1994	LCRC #7095	Bueche	Kent County Monument

P.A. 345 1990 KENT COUNTY

PEER APPROVED 3/7/96

CHAIRMAN *Handwritten signature*

The position of this corner was previously approved by the Kent County Remonumentation Peer Group, monumented by John A. Merdzinski on 5/21/81 and was recorded per LCRC #1886

B. Description of corner evidence found and/or method applied in restoring or reestablishing corner:

C-6 Found standard Kent Co. Mon. (Harrison) per witnesses from above LCRC as set by John A. Merdzinski in place of the 3/4" Iron he found inside a Mon. Box. Said Iron checks with Kent Co. Wit. and LCRC #577.

<u>LCRC #1886</u>	NW cor. frm. hse.	S50°E 138.71'	NE cor. conc. sign	S45°W 93.76'
	NE cor. conc. sign	S45°W 93.76'	Nail/tag CP Pole	N25°W 72.40'
	Nail/tag C.P. Pole	N26°E 71.39'	"X" cut conc. base wk. signal	N30°E 83.42'
	Nail/tag C.P. Pole	N25°W 72.40'	SE cor. brick sign	N55°E 93.56'
	Nail/tag C.P. Pole	N65°W 149.67'		

The selected location is accepted by me and is generally accepted by professional surveyors as the best available evidence of the position of the original corner.

C. Description of monument for corner and accessories established to perpetuate locating the position of the corner:

C-6 Standard Kent County Monument		
NE corner concrete sign	S45°W	93.79'
Nail & KC Remon. tag NE side CP Pole	N25°W	72.35'
"X" cut conc. base of walk signal	N30°E	83.42'
SE corner brick sign	N55°E	93.56'
Set Nail & KC Remon. tag NE side 12" Maple	S45°E	101.26'
On C/L bit. road N-S ± & tree row East ±		



Signed by *Handwritten signature*
Surveyor's Michigan License No. 30077

Date 3/1/96