SURVEY & REMONUMENTATION

FEB 1 4 1997

COMMISSION

KENT COUNTY REMONUMENTATION

LAND CORNER RECORDATION CERTIFICATE

Filing Requirement of Act 74, Mich. P.A. 1970

STATE OF MICHIGAN
COUNTY OF KENT
RECEIVED FOR RECORD
96 MAR 20 AM 8:45
REG. OF DEEDS

8945

Register of Deeds Stamp & File Number

For corners in KENT COUNTY (County)

	Located In:	Corner Code #
1. Public Land Survey	T 6N R 10W	C-13
	T___ R___	
	T___ R___	
	T___ R___	
2. Property Controlling in Section	S___ T___ R___	
	S___ T___ R___	
3. Miscellaneous Property in Sec.	S___ T___ R___	
	S___ T___ R___	

4. Lot No. _____, Recorded Plat _____

5. Private Claims _____

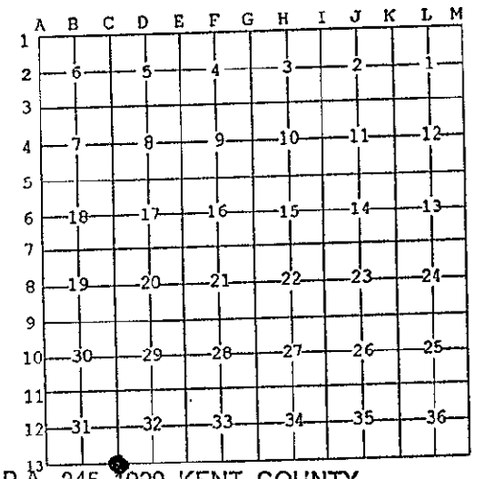

I, Kirk Breitels, in a field survey on Feb. 6, 19 96 do hereby state that under requirements of P.A. 74, Michigan P.A. of 1970, the corner points mentioned in lines 1 and 2 above were in conformance with regulations and rules therefore as required in the current manual of survey instructions of the United States Department of the Interior, Bureau of Land Management or by a decree of a Court of Law and /or that the corner points mentioned in lines 3, 4 and 5 above were in conformance with the rules of the Michigan Board of Land Surveyors or by a Decree of a Court of Law; established, re-established, monumented, recovered, found as expressed below:

NOTE: Not more than 2 corners, all in the same town and range, may be recorded on this certificate.

P.A. 345 1990 KENT COUNTY
PEER APPROVED 3/7/96
CHAIRMAN [signature]

A. Description of original monument and accessories and/or subsequent restoration:

C-13	1831	GLO	Mullett	Set Post
	1959	Kent Co. Wit.		Mon. Box
	1972	LCRC #238	Spicer	1/2" Iron in Mon. Box
	1981	LCRC #1696	Merdzinski	Set Kent County Monument in Mon. Box
	1994	LCRC #7100	Bueche	Kent County Monument in Mon. Box

The position of this corner was previously approved by the Kent County Remonumentation Peer Group, monumented by John A. Merdzinski on 2/20/81 and was recorded per LCRC #1696

B. Description of corner evidence found and/or method applied in restoring or reestablishing corner:

C-13 Found standard Kent Co. Mon. (Harrison) per witnesses from above LCRC as set by John A. Merdzinski in place of the 1/2" Iron he found over a "T" Iron inside a Mon. Box. Both Irons check with Kent Co. Wit. and LCRC #238.

LCRC #1696 & #7100

"X" cut in E. end culv.	N30°E 38.54'	Iron in Mon. Box	West 24.37'
"X" cut in W. end culv.	N50°W 56.75'	KC Mon.	West 12.40'
Nail & KC Rem. tag W. side 12" Maple	N20°E 79.12'		
Nail & KC Rem. tag E. side P. Pole	S40°W 82.10'		
Nail & KC Rem. tag S. side P. Pole	S50°E 114.99'		

The selected location is accepted by me and is generally accepted by professional surveyors as the best available evidence of the position of the original corner.

C. Description of monument for corner and accessories established to perpetuate locating the position of the corner:

C-13 Standard Kent County Monument in Mon. Box

C/L top of E. end culv.		N30°E	38.30'
"X" cut in W. end culv.		N50°W	56.67'
Nail & KC Remon. tag W. side 12" Maple		N20°E	79.19'
Nail & KC Remon. tag E. side P. Pole		S40°W	82.10'
Set Nail & KC Remon. tag SE side P. Pole		S50°E	115.50'
Iron in Mon. Box		West	24.37'
Kent County Mon. (C-1, T5N, R10W)		West	12.40'
C/L Kraft Ave. N-S is West 11.5'±			

STATE OF MICHIGAN
KIRK BREITELS
LAND SURVEYOR
NO 30077
LICENSED LAND SURVEYOR

Signed by [signature] Date 3/1/96

Surveyor's Michigan License No. 30077

FORM APPROVED BY MICHIGAN STATE BOARD OF PROFESSIONAL SURVEYORS, JAN. 28, 1971
REVISED MAY 14,1975
REVISED JAN., 1983
REVISED OCT., 1995