

SURVEY & REMONUMENTATION

FEB 14 1997

KENT COUNTY REMONUMENTATION

COMMISSION

LAND CORNER RECORDATION CERTIFICATE
Filing Requirement of Act 74, Mich. P.A. 1970

For corners in
KENT COUNTY

Located In:

Corner Code #

1. Public Land Survey	T <u>6N</u> R <u>10W</u>	<u>D-1</u>
	T _____ R _____	_____
	T _____ R _____	_____
	T _____ R _____	_____
2. Property Controlling in Section	S _____ T _____ R _____	_____
	S _____ T _____ R _____	_____
3. Miscellaneous Property in Sec.	S _____ T _____ R _____	_____
	S _____ T _____ R _____	_____

STATE OF MICHIGAN
COUNTY OF KENT
RECEIVED FOR RECORD

96 MAR 20 AM 8:45

REG. OF DEEDS

Lucy Bond

8946

Register of Deeds Stamp & File Number

4. Lot No. _____, Recorded Plat _____
5. Private Claims _____

I, Kirk Breitels, in a field survey on Feb. 9, 19 96 do hereby state that under requirements of P.A. 74, Michigan P.A. of 1970, the corner points mentioned in lines 1 and 2 above were in conformance with regulations and rules therefore as required in the current manual of survey instructions of the United States Department of the Interior, Bureau of Land Management or by a decree of a Court of Law and/or that the corner points mentioned in lines 3, 4 and 5 above were in conformance with the rules of the Michigan Board of Land Surveyors or by a Decree of a Court of Law; established, re-established, monumented, recovered, found as expressed below:

NOTE: Not more than 2 corners, all in the same town and range, may be recorded on this certificate.

	A	B	C	D	E	F	G	H	I	J	K	L	M
1													
2	6		5		4		3		2		1		
3													
4	7		8		9		10		11		12		
5													
6	18		17		16		15		14		13		
7													
8	19		20		21		22		23		24		
9													
10	30		29		28		27		26		25		
11													
12	31		32		33		34		35		36		
13													

A. Description of original monument and accessories and/or subsequent restoration:

D-1	1831	GLO	Mullett	Not Set	P.A. 345 1990 KENT COUNTY
		Kent Co. Wit.		Witnesses given	PEER APPROVED 3/7/96
	1975	LCRC #851	Nederveld	1/2" Solid Rod	CHAIRMAN <i>Stan Heber</i>
	1976	LCRC #933	Bonnema	Large Spike	
	1980	LCRC #1327	Byl	RR Spike	
	1984	LCRC #3972	Rosema	Set Kent County Monument	
	1989	LCRC #5155	Chettleburgh	Kent County Monument	

The position of this corner was previously approved by the Kent County Remonumentation Peer Group, monumented by Maurice J. Rosema on 9/5/84 and was recorded per LCRC #3972

B. Description of corner evidence found and/or method applied in restoring or reestablishing corner:


D-1 Found standard Kent Co. Mon. (Harrison) per witnesses from above LCRC as set by Maurice J. Rosema on Twp. Line in place of the 1" Iron with 2" head he found. Said Iron checks with Kent Co. Wit. and LCRC's #851, #933, #1327.

<u>LCRC #3972</u>	<u>LCRC #5155 (Nail/tag in trees-poles)</u>
Nail/tag 58" Ash S55°E 40.04'	52" Ash S50°E 39.94' TP S03°W 17.07'
Nail/tag dbl. 15" Ash N38°E 57.30'	Twin 13" Ash N39°E 57.33'
Nail/tag 12" Hickory N44°W 43.95'	Tw. 9" Box Elder S69°W 66.80'
Nail/tag 12" Apple S26°W 60.05'	11" Hickory N42°W 43.95'
KC Mon. (D-13, 7-10) East 78.74'	KC Mon. (d-13, 7-10) East 78.77'

The selected location is accepted by me and is generally accepted by professional surveyors as the best available evidence of the position of the corner.

C. Description of monument for corner and accessories established to perpetuate locating the position of the corner:

D-1 Standard Kent County Monument	
Nail & KC Remon. tag SE side Twin 18" Ash	N39°E 57.37'
Nail & KC Remon. tag NE side 56" Ash	S50°E 39.94'
Nail & KC Remon. tag W. side Tele. Pole	S03°W 17.01'
New Nail & KC Remon. tag NW side Tw. 14" Box Elder	S69°W 66.80'
Nail & KC Remon. tag NE side 14" Hickory	N42°W 43.95'
Kent Co. Mon. (D-13, T7N, R10)	East 78.77'
C/L E-W bit. road - North 1.5'±	

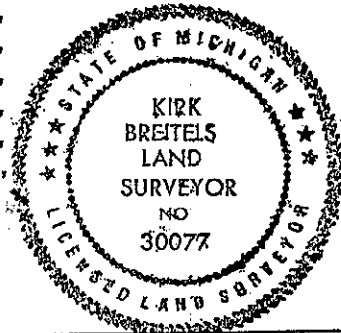

Signed by *Kirk Breitels*
Surveyor's Michigan License No. 30077

Date 3/1/96