

FEB 14 1997

COMMISSION

KENT COUNTY REMONUMENTATION

LAND CORNER RECORDATION CERTIFICATE
Filing Requirement of Act 74, Mich. P.A. 1970

For corners in
KENT COUNTY
(County)

Located In:	Corner Code #
T6N R 10W	D-2
T R	
T R	
T R	
T R	
S T R	
S T R	
S T R	
S T R	

- Public Land Survey
- Property Controlling in Section
- Miscellaneous Property in Sec.

STATE OF MICHIGAN
COUNTY OF KENT
RECEIVED FOR RECORD

96 SEP 13 PM 12:06

REG. OF DEEDS

Lucy Stand

9366
Register of Deeds Stamp & File Number

- Lot No. _____, Recorded Plat _____
- Private Claims _____

I, Kirk Breitels, in a field survey on Aug. 28, 1996 do hereby state that under requirements of P.A. 74, Michigan P.A. of 1970, the corner points mentioned in lines 1 and 2 above were in conformance with regulations and rules therefore as required in the current manual of survey instructions of the United States Department of the Interior, Bureau of Land Management or by a decree of a Court of Law and for that the corner points mentioned in lines 3, 4 and 5 above were in conformance with the rules of the Michigan Board of Land Surveyors or by a Decree of a Court of Law, established, re-established, monumented, recovered, found as expressed below:

	A	B	C	D	E	F	G	H	I	J	K	L	M
1													
2	6			5		4		3		2		1	
3													
4	7		8		9		10		11		12		
5													
6	18		17		16		15		14		13		
7													
8	19		20		21		22		23		24		
9													
10	30		29		28		27		26		25		
11													
12	31		32		33		34		35		36		
13													

NOTE: Not more than 2 corners, all in the same town and range, may be recorded on this certificate.

A. Description of original monument and accessories and/or subsequent restoration:

- D-2 1831---GLO---Not Set 1916---Williams & Works---Small Apple Tree
---Kent Co. Wit.---Iron
12" Stump NE 14.8 12" Oak NNE 54.45'
- 1974---"Chamonix No. 2"---Exxel---NW corner of plat is the intersection of the N-S 1/4 line of Sec. 5 and the North line of the SE 1/4 of Sec. 5
- 1975---LCRC #851---Nederveld---Iron
12" Oak SE 5.16 8" Oak W 11.50' 10" Hickory NW 12.28'
- 1976---LCRC #933---Bonnema---1/2" Iron Pipe
14" Oak SE 5.17' 8" Oak W 11.50' 8" Hick. NNW 12.26' 24" Oak NNE 55.15'

B. Description of corner evidence found and/or method applied in restoring or reestablishing corner:


D-2 Found Concrete Monument per all witnesses ± of LCRC #851 & #933 and witness ± to the 12" Oak from Kent Co. Wit. Said Concrete Monument is 14.6' W. and 1.2' N. from the intersection of 1/4 lines. Said Concrete Monument agrees with measurements of adjoining plats and measurements of others ±.

PEER APPROVED 8/22/96
Hamphubee
CHAIRMAN

The Concrete Monument is accepted by me and is generally accepted by professional surveyors as the best available evidence of the position of the corner.

C. Description of monument for corner and accessories established to perpetuate locating the position of the corner:

- D-2 Set Standard Kent County Monument in place of the Concrete Monument
- Set Nail & KC Remon. tag SW side 15" Oak S35°E 5.05'
- Set Nail & KC Remon. tag N. side 10" Oak S90°W 11.47'
- Spike in W. side 8" Hickory N30°W 12.32'
- Set Nail & KC Remon. tag E. side 27" Oak N30°E 55.04'
- Set Nail & KC Remon. tag N. side 15" Oak S85°E 18.38'
- On fence line to East
- Fence line to West is North 11'±
- Fence to South is 50'± East

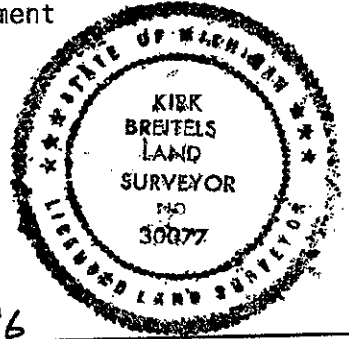

Signed by *Kirk Breitels*
Surveyor's Michigan License No. 30077

Date 9/4/96