

FEB 14 1997

COMMISSION

**KENT COUNTY REMONUMENTATION**

**LAND CORNER RECORDATION CERTIFICATE**  
Filing Requirement of Act 74, Mich. P.A. 1970

For corners in  
**KENT COUNTY**  
(County)

Located in:	Corner Code #
T 6N R 10W	D-3
T R	
T R	
T R	
T R	
S T R	
S T R	
S T R	
S T R	

- Public Land Survey
- Property Controlling in Section
- Miscellaneous Property in Sec.


4. Lot No. \_\_\_\_\_, Recorded Plat \_\_\_\_\_  
5. Private Claims \_\_\_\_\_

I, Kirk Breitels, in a field survey on Feb. 5, 1996 do hereby state that under requirements of P.A. 74, Michigan P.A. of 1970, the corner points mentioned in lines 1 and 2 above were in conformance with regulations and rules therefore as required in the current manual of survey instructions of the United States Department of the Interior, Bureau of Land Management or by a decree of a Court of Law and/or that the corner points mentioned in lines 3, 4 and 5 above were in conformance with the rules of the Michigan Board of Land Surveyors or by a Decree of a Court of Law, established, re-established, monumented, recovered, found as expressed below:

NOTE: Not more than 2 corners, all in the same town and range, may be recorded on this certificate.

STATE OF MICHIGAN  
COUNTY OF KENT  
RECEIVED FOR RECORD  
96 MAR 20 AM 8:45  
REG. OF DEEDS  
*Eric J. Bond*

**8947**  
Register of Deeds Stamp & File Number

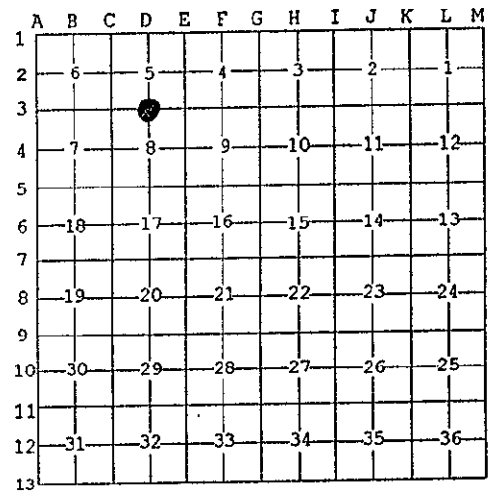

A. Description of original monument and accessories and/or subsequent restoration:

D-3	1831	GLO	Mullett	Set Post
		Kent Co. Wit.		Mon. Box
	1972	LCRC #164	Bonnema	Monument
	1982	LCRC #2730	Merdzinski	Set Kent County Monument
	1994	LCRC #7101	Bueche	Kent County Monument

P.A. 345 1990 KENT COUNTY  
PEER APPROVED 3/7/96  
CHAIRMAN *Harry Huber*

The position of this corner was previously approved by the Kent County Remonumentation Peer Group, monumented by John A. Merdzinski on 2/3/82 and was recorded per LCRC #2730

B. Description of corner evidence found and/or method applied in restoring or reestablishing corner:

D-3 Found standard Kent Co. Mon. (Harrison) per witnesses from above LCRC as set by John A. Merdzinski in place of the Conc. Monument he found. Said Conc. Monument checks with Kent Co. Wit. and LCRC #164.

LCRC #2730		LCRC #7101	
Nail/tag 18" Oak	S45°W 50.75'	Nail/tag 26" Oak	S45°W 50.67'
Nail/tag 12" Hickory	West 35.56'	Nail 16" Hickory	N90°W 35.22'
Nail/tag 10" Hickory	N10°W 24.23'	Nail 8" Oak	N00°E 23.94'
Nail/tag 12" Cherry	N45°E 44.91'	Nail 12" dbl. 12" Cherry	S30°E 26.91'
Nail/tag 8" Cherry	S65°E 11.10'	New fence East	

The selected location is accepted by me and is generally accepted by professional surveyors as the best available evidence of the position of the original corner.

C. Description of monument for corner and accessories established to perpetuate locating the position of the corner:

D-3 Standard Kent County Monument	
Nail & KC Remon. tag SE side 26" Oak	S45°W 50.70'
Large Nail N. side 16" Hickory	N90°W 35.56'
Large Nail W. side 8" Oak	N00°E 23.94'
Large Nail N. side dbl. 12" Cherry	S30°E 26.91'
Set Nail & KC Remon. tag S. side 12" Cherry	N85°E 23.55'
On Fence East	



Signed by *Kirk Breitels*  
Surveyor's Michigan License No. 30077

Date 3/1/96