

**SURVEY & MONUMENTATION**

FEB 14 1997

**KENT COUNTY REMONUMENTATION**

**COMMISSION**

**LAND CORNER RECORDATION CERTIFICATE**  
Filing Requirement of Act 74, Mich. P.A. 1970

For corners in  
KENT COUNTY  
(County)

Located In: Corner Code #

1. Public Land Survey	T <u>6</u> N	R <u>10</u> W	D-4
	T	R	
	T	R	
	T	R	
2. Property Controlling in Section	S	T	R
	S	T	R
3. Miscellaneous Property in Sec.	S	T	R
	S	T	R

STATE OF MICHIGAN  
COUNTY OF KENT  
RECEIVED FOR RECORD  
96 OCT 18 AM 8:19  
REG. OF DEEDS  
*Lucy Standa*

9386

Register of Deeds Stamp & File Number

4. Lot No. \_\_\_\_\_, Recorded Plat \_\_\_\_\_  
5. Private Claims \_\_\_\_\_

I, Kirk Breitels, in a field survey on Sept. 6, 1996 do hereby state that under requirements of P.A. 74, Michigan P.A. of 1970, the corner points mentioned in lines 1 and 2 above were in conformance with regulations and rules therefore as required in the current manual of survey instructions of the United States Department of the Interior, Bureau of Land Management or by a decree of a Court of Law and /or that the corner points mentioned in lines 3, 4 and 5 above were in conformance with the rules of the Michigan Board of Land Surveyors or by a Decree of a Court of Law, established, re-established, monumented, recovered, found as expressed below:

NOTE: Not more than 2 corners, all in the same town and range, may be recorded on this certificate.

A	B	C	D	E	F	G	H	I	J	K	L	M
1												
2	6	5	4	3	2	1						
3												
4	7	8	9	10	11	12						
5												
6	18	17	16	15	14	13						
7												
8	19	20	21	22	23	24						
9												
10	30	29	28	27	26	25						
11												
12	31	32	33	34	35	36						
13												

A. Description of original monument and accessories and/or subsequent restoration:

- D-4 1831---GLO---Not Set
- 1930-50---Williams & Works---Set/Used Iron at intersection of 1/4 lines  
24" Oak SSE 28.65' 6" dbl. Oak SW 33.80' 30" Oak SE 60.15'
- 1957-65---Williams & Works---Boat Spike
- 1973---LCRC #547---VanKooten---Bolt Spike  
NE cor. brick gar. SSW 114.26' 30" Oak SE 30.28'  
SW cor. hse. fnd. NNE 106.91' Iron N 33.38'
- 1974-83---Surveys---Exxel Eng.---Boat Spike (Same witnesses as LCRC #547)


B. Description of corner evidence found and/or method applied in restoring or reestablishing corner:

- D-4 Found Boat Spike over 1" Iron Pipe with following witnesses:  
Tw. 20" Oak SW 35' 40" Oak SE 30' Capped Iron N 33.00'  
42" Oak ESE 61' NE cor. brick gar. SSW 114.26'  
SW cor. hse. fnd. NNE 106.91'
- The Boat Spike over 1" Iron Pipe is 0.7' W. and 0.3' S. from intersection of 1/4 lines and agrees with measurement of adjoining plats and measurements of surveys by Exxel Eng., Medema & VanKooten and Williams & Works.

The Boat Spike over 1" Iron Pipe is accepted by me and is generally accepted by professional surveyors as the best available evidence of the position of the corner.

C. Description of monument for corner and accessories established to perpetuate locating the position of the corner:

- D-4 Set Standard Kent County Monument in place of the Boat Spike and 1" Iron Pipe.  
Set Nail & KC Remon. tag W. side Tw. 20" Oak S50°W 34.91'  
Set Nail & KC Remon. tag N. side 42" Oak S75°E 61.18'  
Set Nail & KC Remon. tag NE side 40" Oak S20°E 30.01'  
NW corner brick house #5986 S45°W 148.49'  
NE corner house siding S50°E 130.94'  
Capped Rerod North 33.00'

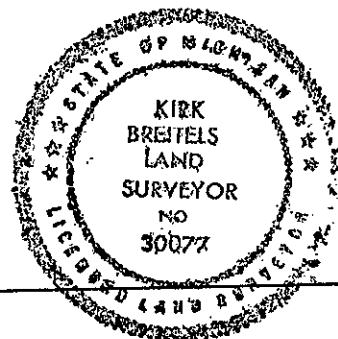

Signed by *Kirk Breitels*  
Surveyor's Michigan License No. 30077

Date 10/11/96

P.A. 345 1990 KENT COUNTY  
PEER APPROVED 7/25/96  
CHAIRMAN *Harold Hubert*