

SURVEY & REMONUMENTATION

FEB 14 1997

COMMISSION

KENT COUNTY REMONUMENTATION

LAND CORNER RECORDATION CERTIFICATE
Filing Requirement of Act 74, Mich. P.A. 1970

STATE OF MICHIGAN
COUNTY OF KENT
RECEIVED FOR RECORD
96 MAR 20 AM 8:45
REG. OF DEEDS

For corners in
KENT COUNTY
(County)

Located In: _____ Corner Code # _____

1. Public Land Survey T 6N R 10W D-5
T _____ R _____
T _____ R _____
T _____ R _____

2. Property Controlling in Section S _____ T _____ R _____
S _____ T _____ R _____

3. Miscellaneous Property in Sec. S _____ T _____ R _____
S _____ T _____ R _____

4. Lot No. _____, Recorded Plat _____


5. Private Claims _____

8948

Register of Deeds Stamp & File Number

I, Kirk Breitels, in a field survey on Feb. 5, 19 96 do hereby state that under requirements of P.A. 74, Michigan P.A. of 1970, the corner points mentioned in lines 1 and 2 above were in conformance with regulations and rules therefore as required in the current manual of survey instructions of the United States Department of the Interior, Bureau of Land Management or by a decree of a Court of Law and for that the corner points mentioned in lines 3, 4 and 5 above were in conformance with the rules of the Michigan Board of Land Surveyors or by a Decree of a Court of Law, established, re-established, monumented, recovered, found as expressed below:

NOTE: Not more than 2 corners, all in the same town and range, may be recorded on this certificate.

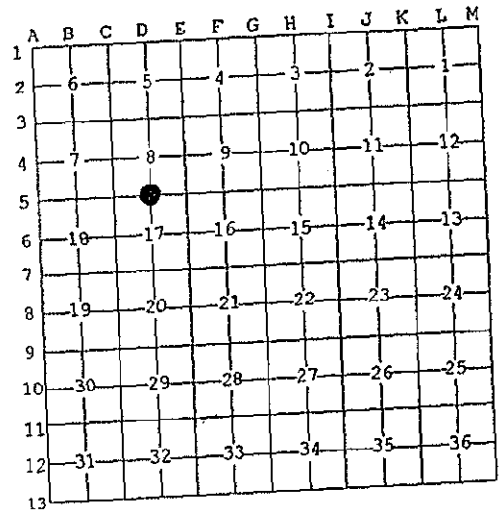

A. Description of original monument and accessories and/or subsequent restoration:

- | | | | | |
|-----|--------|------------------|------------|--------------------------------------|
| D-5 | 1831 | GLO | Mullett | Set Post |
| | 1959 | Kent Co. Wit. | | Mon. Box |
| | 1972-3 | LCRC #155 & #590 | Bonnema | Mon. Box |
| | 1974 | LCRC #647 | VanKooten | 1/2" Iron in Mon. Box |
| | 1982 | LCRC #2968 | Merdzinski | Set Kent County Monument in Mon. Box |
| | 1994 | LCRC #7102 | Bueche | Kent County Monument in Mon. Box |
- The position of this corner was previously approved by the Kent County Remonumentation Peer Group, monumented by John A. Merdzinski on 3/31/82 and was recorded per LCRC #2968

P.A. 345 1000 KENT COUNTY
PEER APPROVED 3/7/96
CHAIRMAN [Signature]

B. Description of corner evidence found and/or method applied in restoring or reestablishing corner:


D-5 Found standard Kent Co. Mon. (Harrison) per witnesses from above LCRC as set by John A. Merdzinski in place of the Iron over a 1/2" Iron he found inside a Mon. Box. Both Irons check with Kent Co. Wit. and LCRC's #155, #590 and #647.
LCRC #2968 & #7102

- | | | |
|--------------------------------------|-------|--------|
| Nail & KC Remon. tag W. side P. Pole | N25°E | 51.70' |
| Nail & KC Remon. tag W. side P. Pole | S10°W | 61.77' |
| Top C/L of hydrant | S60°E | 74.30' |
| NE corner of CB casting | S70°W | 52.35' |
| SE corner of CB casting | N40°W | 45.61' |

The selected location is accepted by me and is generally accepted by professional surveyors as the best available evidence of the position of the original corner.

C. Description of monument for corner and accessories established to perpetuate locating the position of the corner:

- | | | |
|---|-------|--------|
| D-5 Standard Kent County Monument in Mon. Box | N25°E | 51.70' |
| Nail & KC Remon. tag W. side P. Pole | S10°W | 61.72' |
| Nail & KC Remon. tag W. side P. Pole | S60°E | 74.33' |
| Top C/L of hydrant | S70°W | 52.35' |
| NE corner of CB casting | N40°W | 45.58' |
- C/L joint of 28th St. is North 3.9'±

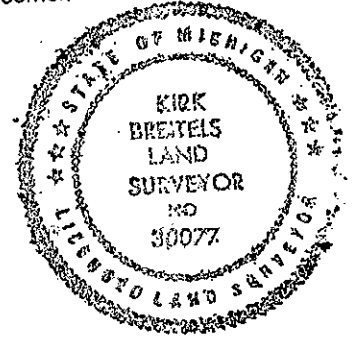

Signed by [Signature]
Surveyor's Michigan License No. 30077

Date 3/1/96