

SURVEY & REMONUMENTATION

FEB 14 1997

KENT COUNTY REMONUMENTATION

COMMISSION

LAND CORNER RECORDATION CERTIFICATE
Filing Requirement of Act 74, Mich. P.A. 1970

For corners in

KENT COUNTY

(County)

Located In:

Corner Code #

1. Public Land Survey	T 6N R 10W	D-6
	T _____ R _____	_____
	T _____ R _____	_____
	T _____ R _____	_____
2. Property Controlling in Section	S _____ T _____ R _____	_____
	S _____ T _____ R _____	_____
3. Miscellaneous Property in Sec.	S _____ T _____ R _____	_____
	S _____ T _____ R _____	_____

STATE OF MICHIGAN
COUNTY OF KENT
RECEIVED FOR RECORD
96 OCT 18 AM 8:19
REG. OF DEEDS
Lucy Spindel
9387
Register of Deeds Stamp & File Number

4. Lot No. _____, Recorded Plat _____
5. Private Claims _____

I, Kirk Breitels, in a field survey on Sept. 6, 1996, do hereby state that under requirements of P.A. 74, Michigan P.A. of 1970, the corner points mentioned in lines 1 and 2 above were in conformance with regulations and rules therefore as required in the current manual of survey instructions of the United States Department of the Interior, Bureau of Land Management or by a decree of a Court of Law and/or that the corner points mentioned in lines 3, 4 and 5 above were in conformance with the rules of the Michigan Board of Land Surveyors or by a Decree of a Court of Law; established, re-established, monumented, recovered, found as expressed below:

NOTE: Not more than 2 corners, all in the same town and range, may be recorded on this certificate.

A	B	C	D	E	F	G	H	I	J	K	L
1											
2	6		5		4		3		2		1
3											
4	7		8		9		10		11		12
5											
6	18		17		16		15		14		13
7											
8	19		20		21		22		23		24
9											
10	30		29		28		27		26		25
11											
12	31		32		33		34		35		36
13											

A. Description of original monument and accessories and/or subsequent restoration:

D-6 1831---GLO---Not Set
1959-66---Williams & Works---Set/Used Iron at intersection 1/4 lines
C/L 6' tall 12" conc. post is 3.9' East
-----Kent Co. Wit.---12" Conc. Post 6' high
-----Surveys---Exxel Eng.---Used intersection of 1/4 lines

B. Description of corner evidence found and/or method applied in restoring or reestablishing corner:


D-6 Found nothing at corner. Established intersection of 1/4 lines.

Plat corner of "Foremost Centennial Park No. 1" fits intersection of 1/4 lines.
Intersection of 1/4 lines agrees with measurements of others.

The intersection of 1/4 lines is accepted by me and is generally accepted by professional surveyors as the best available evidence of the position of the corner.

C. Description of monument for corner and accessories established to perpetuate locating the position of the corner:

D-6 Set Standard Kent County Monument at the intersection of 1/4 lines
E'ly face of conc. light pole S70°W 10.44'
NE'ly corner of C.B. grate S35°E 4.84'
NW'ly corner of C.B. grate N60°E 26.83'
Top C/L fire hydrant N40°W 147.96'
Angle point of back of curbs (pkg. lot) S00°E 89.42'

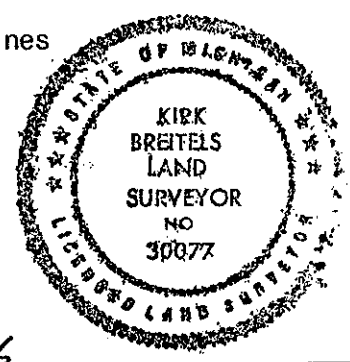

Signed by *Kirk Breitels*
Surveyor's Michigan License No. 30077

Date 10/11/96

P.A. 345 1900 KENT COUNTY,
PEER APPROVED 7/25/96
CHAIRMAN *Harry Hubert*