

# SURVEY & REMONUMENTATION

FEB 14 1997

KENT COUNTY REMONUMENTATION

## COMMISSION LAND CORNER RECORDATION CERTIFICATE Filing Requirement of Act 74, Mich. P.A. 1970

For corners in

KENT COUNTY

(County)

Located In:

Corner Code #

- |                                    |                                     |     |  |
|------------------------------------|-------------------------------------|-----|--|
| 1. Public Land Survey              | T <u>6N</u> R <u>10W</u>            | E-8 |  |
|                                    | T <u>  </u> R <u>  </u>             |     |  |
|                                    | T <u>  </u> R <u>  </u>             |     |  |
|                                    | T <u>  </u> R <u>  </u>             |     |  |
| 2. Property Controlling in Section | S <u>  </u> T <u>  </u> R <u>  </u> |     |  |
|                                    | S <u>  </u> T <u>  </u> R <u>  </u> |     |  |
| 3. Miscellaneous Property in Sec.  | S <u>  </u> T <u>  </u> R <u>  </u> |     |  |
|                                    | S <u>  </u> T <u>  </u> R <u>  </u> |     |  |

STATE OF MICHIGAN  
 COUNTY OF KENT  
 RECEIVED FOR RECORD  
 96 MAR 20 AM 8:45  
 REG. OF DEEDS  
*Wickham*

8957

Register of Deeds Stamp & File Number

4. Lot No. \_\_\_\_\_, Recorded Plat \_\_\_\_\_  
 5. Private Claims \_\_\_\_\_

I, Kirk Breitels, in a field survey on Feb. 5, 19 96 do hereby state that under requirements of P.A. 74, Michigan P.A. of 1970, the corner points mentioned in lines 1 and 2 above were in conformance with regulations and rules therefore as required in the current manual of survey instructions of the United States Department of the Interior, Bureau of Land Management or by a decree of a Court of Law and for that the corner points mentioned in lines 3, 4 and 5 above were in conformance with the rules of the Michigan Board of Land Surveyors or by a Decree of a Court of Law; established, re-established, monumented, recovered, found as expressed below:

NOTE: Not more than 2 corners, all in the same town and range, may be recorded on this certificate.

	A	B	C	D	E	F	G	H	I	J	K	L	M
1													
2	6		5		4		3		2		1		
3													
4	7		8		9		10		11		12		
5													
6	10		17		16		15		14		13		
7													
8	19		20		21		22		23		24		
9													
10	30		29		28		27		26		25		
11													
12	31		32		33		34		35		36		
13													

A. Description of original monument and accessories and/or subsequent restoration:

- |     |      |               |            |                                      |
|-----|------|---------------|------------|--------------------------------------|
| E-8 | 1831 | GLO           | Mullett    | Set Post                             |
|     | 1959 | Kent Co. Wit. |            | Concrete Monument                    |
|     | 1973 | LCRC #470     | Spicer     | 3/4" Iron Pipe                       |
|     | 1980 | LCRC #1406    | Wickham    | 1/2" Iron in Mon. Box                |
|     | 1981 | LCRC #1588    | Merdzinski | Set Kent County Monument in Mon. Box |
|     | 1994 | LCRC #7113    | Bueche     | Kent County Monument in Mon. Box     |

P.A. 345 1990 KENT COUNTY  
 PEER APPROVED 3/7/96  
 CHAIRMAN Harry Huber

The position of this corner was previously approved by the Kent County Remonumentation Peer Group, monumented by John A. Merdzinski on 2/26/81 and was recorded per LCRC #1588

B. Description of corner evidence found and/or method applied in restoring or reestablishing corner:

E-8 Found standard Kent Co. Mon. (Harrison) per witnesses from above LCRC as set by John A. Merdzinski in place of the 1/2" Iron Pipe he found inside a Mon. Box. Said Iron checks with remaining witness from LCRC #470 and #1406.


LCRC #7113 (most witnesses from LCRC #1588 gone)

- |  |       |        |                           |
|--|-------|--------|---------------------------|
| E. face of N. gate post (gate #24)     | N70°W | 61.17' | E. edge bit - East 21.6'± |
| E. face of S. gate post (gate #24)     | N90°W | 61.15' | On C/L North & West       |
| PK Nail in N. side 8" Cedar            | N90°E | 52.55' |                           |
| "X" cut in conc. curb (8' from S. end) | S20°W | 44.81' |                           |
| "X" cut in conc. curb (8' from N. end) | N20°W | 50.73' |                           |

The selected location is accepted by me and is generally accepted by professional surveyors as the best available evidence of the position of the original corner.

C. Description of monument for corner and accessories established to perpetuate locating the position of the corner:

- |   |       |        |  |
|---|-------|--------|--|
| E-8 Standard Kent County Monument in Mon. Box |       |        |  |
| E. face of N. gate post (gate #24)            | N70°W | 61.17' |  |
| E. face of S. gate post (gate #24)            | N90°W | 61.18' |  |
| Set Nail & KC Remon. tag N. side 8" Cedar     | N90°E | 52.58' |  |
| "X" cut in conc. curb (8' from S. end)        | S20°W | 44.85' |  |
| "X" cut in conc. curb (8' from N. end)        | N20°W | 50.73' |  |
| E. edge bit - East 21.6'±                     |       |        |  |
| On C/L extended North & West                  |       |        |  |

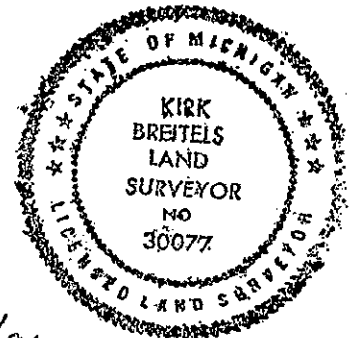

Signed by *Kirk Breitels*  
 Surveyor's Michigan License No. 30077

Date 3/1/96