

SURVEY & REMONUMENTATION

FEB 14 1997

KENT COUNTY REMONUMENTATION

LAND CORNER RECORDATION CERTIFICATE
Filing Requirement of Act 74, Mich. P.A. 1970

COMMISSIONER

For corners in

KENT COUNTY

(County)

Located In:

Corner Code #

1. Public Land Survey	T <u>6N</u> R <u>10W</u>	<u>E-9</u>
	T <u> </u> R <u> </u>	<u> </u>
	T <u> </u> R <u> </u>	<u> </u>
	T <u> </u> R <u> </u>	<u> </u>
2. Property Controlling in Section	S <u> </u> T <u> </u> R <u> </u>	<u> </u>
	S <u> </u> T <u> </u> R <u> </u>	<u> </u>
3. Miscellaneous Property in Sec.	S <u> </u> T <u> </u> R <u> </u>	<u> </u>
	S <u> </u> T <u> </u> R <u> </u>	<u> </u>

STATE OF MICHIGAN
COUNTY OF KENT
RECEIVED FOR RECORD

96 JUN -7 AM 8:26

REG. OF DEEDS

9148

Register of Deeds Stamp & File Number

4. Lot No. _____, Recorded Plat _____
5. Private Claims _____

I, Kirk Breitels, in a field survey on Apr. 2, 19 96 do hereby state that under requirements of P.A. 74, Michigan P.A. of 1970, the corner points mentioned in lines 1 and 2 above were in conformance with regulations and rules therefore as required in the current manual of survey instructions of the United States Department of the Interior, Bureau of Land Management or by a decree of a Court of Law and /or that the corner points mentioned in lines 3, 4 and 5 above were in conformance with the rules of the Michigan Board of Land Surveyors or by a Decree of a Court of Law, established, re-established, monumented, recovered, found as expressed below:

NOTE: Not more than 2 corners, all in the same town and range, may be recorded on this certificate.

A	B	C	D	E	F	G	H	I	J	K	L	M
1												
2	6	5	4	3	2	1						
3												
4	7	8	9	10	11	12						
5												
6	18	17	16	15	14	13						
7												
8	19	20	21	22	23	24						
9												
10	30	29	28	27	26	25						
11												
12	31	32	33	34	35	36						
13												

A. Description of original monument and accessories and/or subsequent restoration:

E-9	1831	GLO	Mullett	Set Post
	1960	Kent Co. Wit.		Iron & Stone
	1975	LCRC #785	Bonnema	"T" Iron
	1982	LCRC #2733	Merdzinski	Set Kent County Monument
	1994	LCRC #7114	Bueche	Kent County Monument

P.A. 345 1990 KENT COUNTY
PEER APPROVED 5/30/96
CHAIRMAN [Signature]

The position of this corner was previously approved by the Kent County Remonumentation Peer Group, monumented by John A. Merzinski on 2/5/82 and was recorded per LCRC #2733

B. Description of corner evidence found and/or method applied in restoring or reestablishing corner:


E-9 Found BROKEN (REPAIRED) standard Kent Co. Mon. (Harrison) per witnesses from above LCRC as set John A. Merdzinski by in place of the "T" Iron and 1" Iron he found over a Stone. All check with Kent Co. Wit. and LCRC #785.

<u>LCRC #2733</u>	NW cor. hse. #4410 fnd.	S55°E 89.20'	<u>LCRC #7114</u>	C/L 4" steel cor. fc. post	South 32.16'
	C/L 4" steel fc. cor. post	South 43.25'		C/L top MBT box	S40°W 46.68'
	C/L 4" steel fc. cor. post	S85°W 53.38'		Fence post on N-S fence	S85°W 53.38'
	Nail/tag 30" Walnut	N35°W 56.93'		Nail/tag 16" Walnut	N70°E 65.77'
	Nail/tag MBT Pole	N55°E 44.95'		Nail/tag Tri. 6" Ash	N30°E 45.10'

The selected location is accepted by me and is generally accepted by professional surveyors as the best available evidence of the position of the original corner.

C. Description of monument for corner and accessories established to perpetuate locating the position of the corner.

E-9	Standard Kent County Monument		
	C/L 4" steel corner fence post	South	43.24'
	C/L top of MBT Box	S40°W	46.7'± (loose)
	C/L fence post on N-S fenceline	S85°W	53.33'
	Nail & KC Remon. tag S. side 16" Walnut	N70°E	65.72'
	Nail & KC Remon. tag W. side Tri. 6" Ash	N30°E	44.86'
	NE face steel corner fence post	S50°W	68.41'
	On C/L old asph. roads to South & East ±		

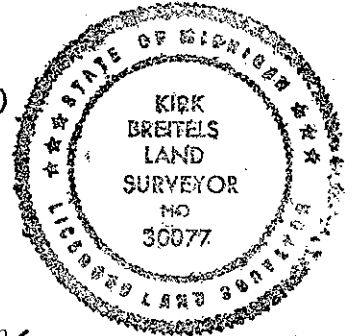

Signed by [Signature]
Surveyor's Michigan License No. 30077

Date 4/19/96