

**SURVEY & REMONUMENTATION**

FEB 14 1997

KENT COUNTY REMONUMENTATION

**COMMISSION LAND CORNER RECORDATION CERTIFICATE**  
Filing Requirement of Act 74, Mich. P.A. 1970

For corners in

KENT COUNTY

(County)

Located In:

Corner Code #

1. Public Land Survey	T <u>6N</u> R <u>10W</u>	E-10
	T ___ R ___	_____
	T ___ R ___	_____
	T ___ R ___	_____
2. Property Controlling in Section	S ___ T ___ R ___	_____
	S ___ T ___ R ___	_____
3. Miscellaneous Property in Sec.	S ___ T ___ R ___	_____
	S ___ T ___ R ___	_____

STATE OF MICHIGAN  
COUNTY OF KENT  
RECEIVED FOR RECORD

96 MAR 20 AM 8:45

REG. OF DEEDS  
*Lucy Bond*

8958

Register of Deeds Stamp & File Number

4. Lot No. \_\_\_\_\_, Recorded Plat \_\_\_\_\_  
5. Private Claims \_\_\_\_\_

I, Kirk Breitels, in a field survey on Feb. 5, 1996 do hereby state that under requirements of P.A. 74, Michigan P.A. of 1970, the corner points mentioned in lines 1 and 2 above were in conformance with regulations and rules therefore as required in the current manual of survey instructions of the United States Department of the Interior, Bureau of Land Management or by a decree of a Court of Law and for that the corner points mentioned in lines 3, 4 and 5 above were in conformance with the rules of the Michigan Board of Land Surveyors or by a Decree of a Court of Law; established, re-established, monumented, recovered, found as expressed below:

NOTE: Not more than 2 corners, all in the same town and range, may be recorded on this certificate.

A	B	C	D	E	F	G	H	I	J	K	L	M
1												
2	6	5	4	3	2	1						
3												
4	7	8	9	10	11	12						
5												
6	18	17	16	15	14	13						
7												
8	19	20	21	22	23	24						
9												
10	30	29	28	27	26	25						
11												
12	31	32	33	34	35	36						
13												

A. Description of original monument and accessories and/or subsequent restoration:

E-10	1831	GLO	Mullett	Set Post
	1953	Kent Co. Wit.		Iron
	1975	LCRC #785	Bonnema	1/2" Iron
	1982	LCRC #2734	Merdzinski	Set Kent County Monument
	1994	LCRC #7115	Bueche	Kent County Monument

P.A. 345 1990 KENT COUNTY  
PEER APPROVED 3/7/96  
CHAIRMAN *Henry Hubert*

The position of this corner was previously approved by the Kent County Remonumentation Peer Group, monumented by John A. Merdzinski on 2/16/82 and was recorded per LCRC #2734

B. Description of corner evidence found and/or method applied in restoring or reestablishing corner:

E-10 Found standard Kent Co. Mon. (Harrison) per witnesses from above LCRC as set by John A. Merdzinski in place of the 1/2" Iron he found over a 1 1/2" Iron. Both Irons check with Kent Co. Wit. and LCRC #785  
LCRC #2734 & #7115


NW cor. conc. hdwll	N75°E	64.1'	Nail/tag 6" Tree	N45°W	47.84'
C/L steel fence post	N45°W	74.1'	Nail/tag 4" Tree	N55°W	65.37'
C/L steel fence post	North	53.15'	Nail/tag 26" Maple	S65°W	53.24'
Nail/tag 18" Cedar	S20°W	30.03'			
Nail/tag 14" Cedar	S65°W	60.87'			

The selected location is accepted by me and is generally accepted by professional surveyors as the best available evidence of the position of the original corner.

C. Description of monument for corner and accessories established to perpetuate locating the position of the corner:

E-10 Standard Kent County Monument

NW cor. conc. headwall	N75°E	64.1'
C/L steel fence post	N45°W	73.6' (leaning)
C/L steel cor. fence post	North	53.15'
Nail & KC Remon. tag NW side 18" Stump	S20°W	30.03'
Nail & KC Remon. tag NW side 14" Stump	S65°W	60.78'
Nail & KC Remon. tag NW side 26" Stump	S60°W	53.24'
On C/L blktp. rd. E-W, On fence line N.		
On brushy row S.		

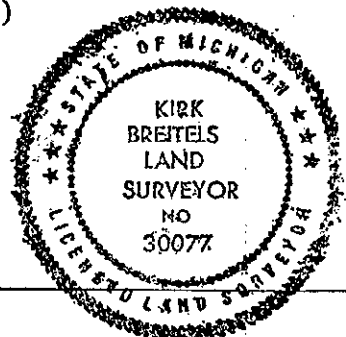

Signed by *Kirk Breitels*  
Surveyor's Michigan License No. 30077

Date 3/1/96