

SURVEY & REMONUMENTATION

FEB 14 1997

KENT COUNTY REMONUMENTATION

COMMISSION

LAND CORNER RECORDATION CERTIFICATE
Filing Requirement of Act 74, Mich. P.A. 1970

For corners in

KENT COUNTY

(County)

Located In:

Corner Code #

1. Public Land Survey

T 6N R 10W

E-13

2. Property Controlling in Section

S T R

3. Miscellaneous Property in Sec.

S T R

4. Lot No. , Recorded Plat

5. Private Claims

I, Kirk Breitels, in a field survey on Feb. 6, 1996 do hereby state that under requirements of P.A. 74, Michigan P.A. of 1970, the corner points mentioned in lines 1 and 2 above were in conformance with regulations and rules therefore as required in the current manual of survey instructions of the United States Department of the Interior, Bureau of Land Management or by a decree of a Court of Law and for that the corner points mentioned in lines 3, 4 and 5 above were in conformance with the rules of the Michigan Board of Land Surveyors or by a Decree of a Court of Law, established, re-established, monumented, recovered, found as expressed below:

NOTE: Not more than 2 corners, all in the same town and range, may be recorded on this certificate.

A. Description of original monument and accessories and/or subsequent restoration:

E-13	1831	GLO	Mullett	Set Post
	1960	Kent Co. Wit.		Iron
	1973	LCRC #550	VanKooten	1/2" Iron
	1981	LCRC #1694	Merdzinski	Set Kent County Monument
	1994	LCRC #7118	Bueche	Kent County Monument

P.A. 345 1990 KENT COUNTY

PEER APPROVED 3/7/96
CHAIRMAN Harry Hubert

The position of this corner was previously approved by the Kent County Remonumentation Peer Group, monumented by John A. Merdzinski on 2/20/81 and was recorded per LCRC #1694

B. Description of corner evidence found and/or method applied in restoring or reestablishing corner:

E-13 Found standard Kent Co. Mon. (Harrison) per witnesses from above LCRC as set by John A. Merdzinski in place of the 1/2" Iron over another 1/2" Iron he found. Both Irons check with Kent Co. Wit. and LCRC #550.
LCRC #1694 & #7118


Nail & KC Remon. tag NE side 34" Maple	S40°E	37.69'	Nail & KC Remon. tag
Nail & KC Remon. tag N. side Tw. 12" Elm	S67°W	67.45'	S. side 30" Cherry
Nail & KC Remon. tag NE side Tw. 10" Maple	N57°W	54.13'	N65°E 70.86'
Nail & KC Remon. tag SW side 10" Maple	N15°W	29.62'	KC Mon., NE cor. 4-5-10
Nail & KC Remon. tag SE side 10" Maple	N55°E	70.86'	West 52.89'

The selected location is accepted by me and is generally accepted by professional surveyors as the best available evidence of the position of the original corner.

C. Description of monument for corner and accessories established to perpetuate locating the position of the corner:

E-13 Standard Kent County Monument

New Nail & KC Remon. tag NE side 38" Maple	S40°E	37.69'
Nail & KC Remon. tag N. side Tw. 12" Elm	S67°W	67.50'
Nail & KC Remon. tag NE side Tw. 10" Maple	N57°W	54.13'
Nail & KC Remon. tag SW side 10" Maple	N15°W	29.62'
Set Nail & KC Remon. tag NW side 12" Maple	N70°E	70.80'
Nail & KC Remon. tag S. side 30" Cherry	N65°E	61.65'
Kent County Mon., NE cor. Sec. 4, T5N, R10W	West	52.89'

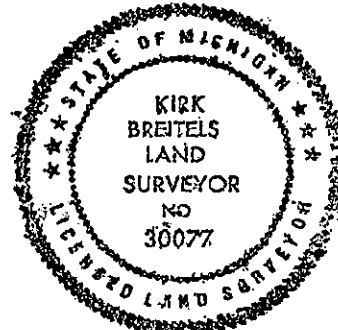

Signed by Kirk Breitels

Date 3/1/96

Surveyor's Michigan License No. 30077

STATE OF MICHIGAN
COUNTY OF KENT
RECEIVED FOR RECORD
96 MAR 20 AM 8:45
REG. OF DEEDS
Lucy Bond
8960
Register of Deeds Stamp & File Number

A	B	C	D	E	F	G	H	I	J	K	L	M
1												
2	6	5	4	3	2	1						
3												
4	7	8	9	10	11	12						
5												
6	18	17	16	15	14	13						
7												
8	19	20	21	22	23	24						
9												
10	30	29	28	27	26	25						
11												
12	31	32	33	34	35	36						
13												