

**SURVEY &  
REMONUMENTATION**

FEB 14 1997

**COMMISSION KENT COUNTY REMONUMENTATION**

**LAND CORNER RECORDATION CERTIFICATE  
Filing Requirement of Act 74, Mich. P.A. 1970**

For corners in  
KENT COUNTY  
(County).

Located In:	Corner Code #
T <u>6N</u> R <u>10W</u>	<u>F-1</u>
T _____ R _____	_____
T _____ R _____	_____
T _____ R _____	_____
S _____ T _____ R _____	_____
S _____ T _____ R _____	_____
S _____ T _____ R _____	_____
S _____ T _____ R _____	_____

1. Public Land Survey
2. Property Controlling in Section
3. Miscellaneous Property in Sec.

4. Lot No. \_\_\_\_\_, Recorded Plat \_\_\_\_\_  
5. Private Claims \_\_\_\_\_

I, Kirk Breitels, in a field survey on Apr. 9, 1996 do hereby state that under requirements of P.A. 74, Michigan P.A. of 1970, the corner points mentioned in lines 1 and 2 above were in conformance with regulations and rules therefore as required in the current manual of survey instructions of the United States Department of the Interior, Bureau of Land Management or by a decree of a Court of Law and/or that the corner points mentioned in lines 3, 4 and 5 above were in conformance with the rules of the Michigan Board of Land Surveyors or by a Decree of a Court of Law; established, re-established, monumented, recovered, found as expressed below:

NOTE: Not more than 2 corners, all in the same town and range, may be recorded on this certificate.

A. Description of original monument and accessories and/or subsequent restoration:

F-1	1831	GLO	Mullett	Not Set
	1979	LCRC #1267	Bonnema	Monument
	1990	LCRC #5492	Bueche	Set Kent County Monument

P.A. 345 1990 KENT COUNTY

PEER APPROVED 5/30/96  
CHAIRMAN [Signature]

The position of this corner was previously approved by the Kent County Remonumentation Peer Group, monumented by John C. Bueche on 5/24/90 and was recorded per LCRC #5492

B. Description of corner evidence found and/or method applied in restoring or reestablishing corner:


F-1 Found standard Kent Co. Mon. (Harrison) per witnesses from above LCRC as set by John C. Bueche on Twp. line in place of the Conc. Monument he found. Said Conc. Monument checks with LCRC #1267.  
LCRC #5492

Nail & Remon. tag E. side Power Pole #32	N10°E	14.64'	KC Mon. (F-13, 6-10)
Nail & Remon. tag N. side 4" Poplar (6' high)	S45°E	60.95'	East 75.72'
Nail & Remon. tag N. side 18" Ash (5' high)	S65°W	83.73'	
Nail & Remon. tag N. side 12" Poplar	N80°W	69.97'	
Nail & Remon. tag N. side 14" Maple	N60°W	76.89'	

The selected location is accepted by me and is generally accepted by professional surveyors as the best available evidence of the position of the corner.

C. Description of monument for corner and accessories established to perpetuate locating the position of the corner:

F-1 Standard Kent County Monument (all wit. EDM Horiz.)			
Nail & Remon. tag E. side Power Pole #32	N10°E	14.66'	
New Nail & Remon. tag N. side 8" Poplar (6' high)	S45°E	60.61'	
New Nail & Remon. tag N. side 20" Ash (5' high)	S65°W	83.57'	
New Nail & Remon. tag N. side 14" Poplar	N80°W	69.86'	
New Nail & Remon. tag N. side 16" Maple	N60°W	76.64'	
Kent Co. Mon. (F-13, T6N, R10)	East	75.72'	

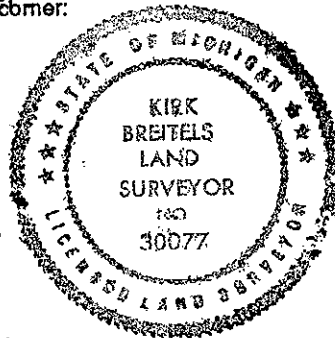

Signed by [Signature]  
Surveyor's Michigan License No. 30077

Date 4/19/96

STATE OF MICHIGAN  
COUNTY OF KENT  
RECEIVED FOR RECORD  
96 JUN -7 AM 8:26  
REG. OF DEEDS  
[Signature]  
**9150**  
Register of Deeds Stamp & File Number

A	B	C	D	E	F	G	H	I	J	K	L	M
1												
2	6		5		4		3		2		1	
3												
4	7		8		9		10		11		12	
5												
6	18		17		16		15		14		13	
7												
8	19		20		21		22		23		24	
9												
10	30		29		28		27		26		25	
11												
12	31		32		33		34		35		36	
13												