

FEB 14 1997

KENT COUNTY REMONUMENTATION

COMMISSION LAND CORNER RECORDATION CERTIFICATE
Filing Requirement of Act 74, Mich. P.A. 1970

For corners in
KENT COUNTY
(County)

Located In:	Corner Code #
T 6N R 10W	F-2
T R	
T R	
T R	
S T R	
S T R	
S T R	
S T R	

- 1. Public Land Survey
- 2. Property Controlling in Section
- 3. Miscellaneous Property in Sec.

4. Lot No. _____, Recorded Plat _____
5. Private Claims _____

I, Kirk Breitels, in a field survey on Mar. 25, 19 96 do hereby state that under requirements of P.A. 74, Michigan P.A. of 1970, the corner points mentioned in lines 1 and 2 above were in conformance with regulations and rules therefore as required in the current manual of survey instructions of the United States Department of the Interior, Bureau of Land Management or by a decree of a Court of Law and /or that the corner points mentioned in lines 3, 4 and 5 above were in conformance with the rules of the Michigan Board of Land Surveyors or by a Decree of a Court of Law, established, re-established, monumented, recovered, found as expressed below:

NOTE: Not more than 2 corners, all in the same town and range, may be recorded on this certificate.

A. Description of original monument and accessories and/or subsequent restoration:

F-2	1831	GLO	Mullett	Not Set
	1960	Kent Co. Wit.		1" Iron
	1972	LCRC #173	Spicer	1" Iron
	1988	LCRC #4939	Bonnema	Set Kent County Monument

P.A. 345 1990 KENT COUNTY.

PEER APPROVED 5/30/96
CHAIRMAN [Signature]

The position of this corner was previously approved by the Kent County Remonumentation Peer Group, monumented by Douglas W. Bonnema on 12/17/88 and was recorded per LCRC #4939

B. Description of corner evidence found and/or method applied in restoring or reestablishing corner:


F-2 Found standard Kent Co. Mon. (Harrison) per witnesses from above LCRC as set by Douglas W. Bonnema from plat information of "Tammarron No. 2". Said location checks remaining witnesses ± of Kent Co. Wit. and LCRC #173.
LCRC #4939

SW corner hse. fnd. #1600	S40°E	31.31'	Nail & KC Remon. tag
NW corner hse. fnd. #1600	N70°E	23.55'	N. side 24" W. Cherry
SW cor. conc. CP Co. pad	N05°E	55.55'	N80°W 49.63'
NE corner hse. fnd. #1610	S90°W	60.53'	
Nail & KC Remon. tag W. side 14" Hickory N05°W 28.21'			

The selected location is accepted by me and is generally accepted by professional surveyors as the best available evidence of the position of the corner.

C. Description of monument for corner and accessories established to perpetuate locating the position of the corner:

F-2 Standard Kent County Monument		
SW corner house foundation #1600	S40°E	31.31'
NW corner house foundation #1600	N70°E	23.55'
SW corner concrete CP Co. pad	N05°E	55.55'
NE corner house foundation #1610	S90°W	60.53'
New Nail & KC Remon. tag W. side 18" Hickory	N05°W	28.21'
New Nail & KC Remon. tag N. side 28" W. Cherry	N80°W	49.63'

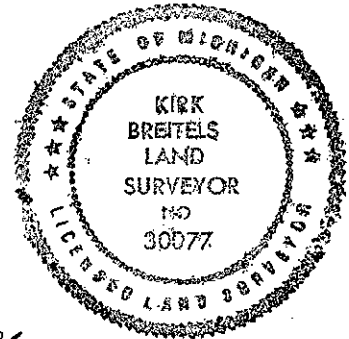

Signed by [Signature]
Surveyor's Michigan License No. 30077

Date 4/19/96

STATE OF MICHIGAN
COUNTY OF KENT
RECEIVED FOR RECORD

96 JUN -7 AM 8:27

REG. OF DEEDS

[Signature]

9151

Register of Deeds Stamp & File Number

A	B	C	D	E	F	G	H	I	J	K	L	M
1												
2	6		5		4		3		2		1	
3												
4	7		8		9		10		11		12	
5												
6	18		17		16		15		14		13	
7												
8	19		20		21		22		23		24	
9												
10	30		29		28		27		26		25	
11												
12	31		32		33		34		35		36	
13												