

REMONUMENTATION

FEB 14 1997

COMMISSION

KENT COUNTY REMONUMENTATION

LAND CORNER RECORDATION CERTIFICATE
Filing Requirement of Act 74, Mich. P.A. 1970

For corners in
KENT COUNTY
(County)

Located In:	Corner Code #
T6N R10W	F-8
T R	
T R	
T R	
T R	
S T R	
S T R	
S T R	
S T R	

1. Public Land Survey

2. Property Controlling in Section

3. Miscellaneous Property in Sec.

4. Lot No. _____, Recorded Plat _____
5. Private Claims _____

I, Kirk Breitels, in a field survey on July 30, 1996 do hereby state that under requirements of P.A. 74, Michigan P.A. of 1970, the corner points mentioned in lines 1 and 2 above were in conformance with regulations and rules therefore as required in the current manual of survey instructions of the United States Department of the Interior, Bureau of Land Management or by a decree of a Court of Law and/or that the corner points mentioned in lines 3, 4 and 5 above were in conformance with the rules of the Michigan Board of Land Surveyors or by a Decree of a Court of Law; established, re-established, monumented, recovered, found as expressed below:

NOTE: Not more than 2 corners, all in the same town and range, may be recorded on this certificate.

A. Description of original monument and accessories and/or subsequent restoration:

- F-8 1831---GLO---Not Set
- 1908-50---Williams & Works---Stone
- 1959---Kent Co. Wit.---Stone with "X"
8" Tw. Maple SSE 22.88' 18" Tw. Maple SSW 13.2' 18" Maple WSW 30.28'
- 1989---LCRC #5331---Chettleburgh---Stone with "X"
Conc. Mon. N 130.52' 12" Oak N08°E 14.34' Conc. Mon. E 74.94'
9" Tw. Ironwood S74°E 22.81' 15" Maple S11°W 13.03' 11" Maple N16°W 24.06'

B. Description of corner evidence found and/or method applied in restoring or reestablishing corner:


- F-8 Found Stone with "X" on top per the following witnesses:
14" Oak N08°E 14.3' Tw. 12" Ironwood S74°E 23.1'
18" Maple S11°W 13.03' 14" Maple N16°W 24.1'

Said Stone with "X" is 3.2' E. and 0.7' N. from intersection of 1/4 lines and agrees with adjoining plat and survey measurements of others.

The Stone with "X" is accepted by me and is generally accepted by professional surveyors as the best available evidence of the position of the corner.

C. Description of monument for corner and accessories established to perpetuate locating the position of the corner:

- F-8 Set Standard Kent County Monument in place of the Stone with "X"
- Set Nail & KC Remon. tag W. side 14" Oak N08°E 14.34'
- Set Nail & KC Remon. tag N. side Tw. 12" Ironwood S74°E 23.10'
- Set Nail & KC Remon. tag W. side 18" Maple S11°W 13.03'
- Set Nail & KC Remon. tag W. side 14" Maple N16°W 24.08'
- Set Nail & KC Remon. tag S. side 20" Maple N65°W 27.10'

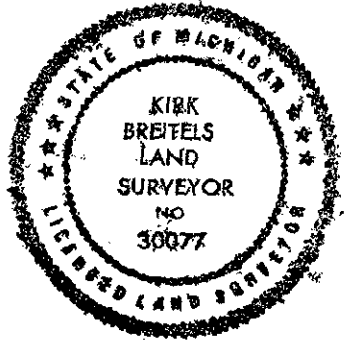

Signed by Kirk Breitels
Surveyor's Michigan License No. 30077

Date 8/25/96

STATE OF MICHIGAN
COUNTY OF KENT
RECEIVED FOR RECORD
96 SEP 13 PM 12:06
REG. OF DEEDS
Lucy Spauld

9375

Register of Deeds Stamp & File Number

	A	B	C	D	E	F	G	H	I	J	K	L	M
1													
2	6		5		4		3		2		1		
3													
4	7		8		9		10		11		12		
5													
6	18		17		16		15		14		13		
7													
8	19		20		21		22		23		24		
9													
10	30		29		28		27		26		25		
11													
12	31		32		33		34		35		36		
13													

P.A. 345 1990 KENT COUNTY
PEER APPROVED 7/25/96
CHAIRMAN Harry Hubert