

**SURVEY &  
REMONUMENTATION**

MAY 28 1997

**KENT COUNTY REMONUMENTATION**

**COMMISSION**

**LAND CORNER RECORDATION CERTIFICATE  
Filing Requirement of Act 74, Mich. P.A. 1970**

STATE OF MICHIGAN  
COUNTY OF KENT  
RECEIVED FOR RECORD  
96 SEP 13 PM 12:06

REG. OF DEEDS

*Lucy Bond*

**9376**

Register of Deeds Stamp & File Number

For corners in  
**KENT COUNTY**

(County)

Located In:

Corner Code #

1. Public Land Survey	T 6N R 10W	F-10
	T R	
	T R	
	T R	
2. Property Controlling in Section	S T R	
	S T R	
3. Miscellaneous Property in Sec.	S T R	
	S T R	

4. Lot No. \_\_\_\_\_, Recorded Plat \_\_\_\_\_  
5. Private Claims \_\_\_\_\_

I, Kirk Breiteis, in a field survey on Aug. 15, 1996 do hereby state that under requirements of P.A. 74, Michigan P.A. of 1970, the corner points mentioned in lines 1 and 2 above were in conformance with regulations and rules therefore as required in the current manual of survey instructions of the United States Department of the Interior, Bureau of Land Management or by a decree of a Court of Law and for that the corner points mentioned in lines 3, 4 and 5 above were in conformance with the rules of the Michigan Board of Land Surveyors or by a Decree of a Court of Law; established, re-established, monumented, recovered, found as expressed below:

NOTE: Not more than 2 corners, all in the same town and range, may be recorded on this certificate.

1	A	B	C	D	E	F	G	H	I	J	K	L	M
2		6		5		4		3		2		1	
3													
4		7		8		9		10		11		12	
5													
6		18		17		16		15		14		13	
7													
8		19		20		21		22		23		24	
9													
10		30		29		28		27		26		25	
11													
12		31		32		33		34		35		36	
13													

A. Description of original monument and accessories and/or subsequent restoration:

- F-10 1831---GLO---Not Set
- 1950---Williams & Works---Set Iron on E-W 1/4 line  
PP SE 64.6' TP NE 33.50' Cor. fc. post N 29.62'  
36" Elm SW 36.3' 16" Apple SE 140.10'
- 1958-68---Williams & Works---Set point per prev. wit.
- 1960---Kent Co. Wit.---Iron (same wit. as 1950 Williams & Works)
- 1987---Williams & Works---Mon. Box
- 1992---LCRC #6716---1" Iron in Mon. Box 0.13' N. & 0.38' W. of Int. 1/4 lines  
"X" on wall NW 95.70' Iron SW 70.37' PP SE 67.81' Nail in curb ENE 65.17'

B. Description of corner evidence found and/or method applied in restoring or reestablishing corner:


- F-10 Found 1" Iron in Mon. Box per the following witnesses:  
Iron SW 70.30'  
PP SE 67.94'

Said Iron in Mon. Box is 0.1' N and 0.2' W. from intersection of 1/4 lines and agrees with survey measurements of others.

The Iron in Mon. Box is accepted by me and is generally accepted by professional surveyors as the best available evidence of the position of the corner.

C. Description of monument for corner and accessories established to perpetuate locating the position of the corner:

- F-10 Set Standard Kent County Monument in Mon. Box in place of the Iron  
N'yly corner of CB header at back curb N50°W 46.26'  
Chiseled "X" in top of conc. curb N50°E 51.28'  
Exxel Capped Iron S50°W 70.30'  
PK Nail in W. side P. Pole S30°E 64.97'

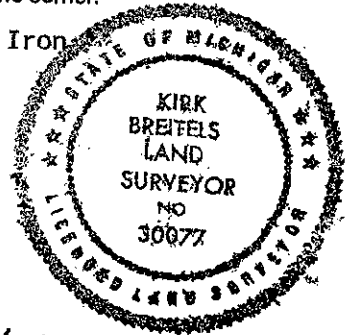

Signed by *Kirk Breiteis*  
Surveyor's Michigan License No. 30077

Date 8/25/96