

SURVEY & REMONUMENTATION

KENT COUNTY REMONUMENTATION

FEB 14 1997

LAND CORNER RECORDATION CERTIFICATE
Filing Requirement of Act 74, Mich. P.A. 1970

For corners in
KENT COUNTY

COMMISSION

Located In: Corner Code #

- | | | |
|------------------------------------|--------------------------|-------------|
| 1. Public Land Survey | T <u>6N</u> R <u>10W</u> | <u>F-11</u> |
| | T _____ R _____ | _____ |
| | T _____ R _____ | _____ |
| | T _____ R _____ | _____ |
| 2. Property Controlling in Section | S _____ T _____ | _____ |
| | S _____ T _____ | _____ |
| 3. Miscellaneous Property in Sec. | S _____ T _____ | _____ |
| | S _____ T _____ | _____ |

REG. OF DEEDS

Lucy Bond

STATE OF MICHIGAN
COUNTY OF KENT
RECEIVED FOR RECORD
96 MAR 20 AM 8:46

8965

Register of Deeds Stamp & File Number

4. Lot No. _____, Recorded Plat _____
5. Private Claims _____

I, Kirk Breitels, in a field survey on Feb. 6, 1996 do hereby state that under requirements of P.A. 74, Michigan P.A. of 1970, the corner points mentioned in lines 1 and 2 above were in conformance with regulations and rules therefore as required in the current manual of survey instructions of the United States Department of the Interior, Bureau of Land Management or by a decree of a Court of Law and /or that the corner points mentioned in lines 3, 4 and 5 above were in conformance with the rules of the Michigan Board of Land Surveyors or by a Decree of a Court of Law, established, re-established, monumented, recovered, found as expressed below:

NOTE: Not more than 2 corners, all in the same town and range, may be recorded on this certificate.

	A	B	C	D	E	F	G	H	I	J	K	L	M
1													
2		6		5		4		3		2		1	
3													
4		7		8		9		10		11		12	
5													
6		18		17		16		15		14		13	
7													
8		19		20		21		22		23		24	
9													
10		30		29		28		27		26		25	
11													
12		31		32		33		34		35		36	
13													

A. Description of original monument and accessories and/or subsequent restoration:

- | | | | | |
|------|------|---------------|------------|--------------------------|
| F-11 | 1831 | GLO | Mullett | Set Post |
| | | Kent Co. Wit. | | Witnesses given |
| 1973 | | LCRC #467 | Spicer | "T" Iron |
| 1981 | | LCRC #1889 | Merdzinski | Set Kent County Monument |
| 1994 | | LCRC #7123 | Bueche | Kent County Monument |

P.A. 345 1990 KENT COUNTY
PEER APPROVED 3/7/96
CHAIRMAN *Henry Huber*

The position of this corner was previously approved by the Kent County Remonumentation Peer Group, monumented by John A. Merdzinski on 5/19/81 and was recorded per LCRC #1889

B. Description of corner evidence found and/or method applied in restoring or reestablishing corner:


F-11 Found standard Kent Co. Mon. (Harrison) per witnesses from above LCRC as set by John A. Merdzinski in place of the "T" Iron over a 1/2" Solid Iron he found. Both Irons check with Kent Co. Wit. and LCRC #467.

- | | | | |
|--------------------------|---------------|--------------------|--------------|
| <u>LCRC #1889</u> | | <u>LCRC #7123</u> | |
| Nail/tag 6" Elm | N20°E 69.96' | Nail/tag 10" Elm | N20°E 69.65' |
| Nail/tag 26" Ash | N90°E 77.33' | Nail/tag 28" Ash | N90°E 77.33' |
| Nail/tag Quad. 6" Poplar | S15°W 87.25' | "X" in conc. culv. | N10°W 81.65' |
| Nail/tag 14" Poplar | S35°W 61.42' | Nail/tag 10" Elm | S40°W 39.75' |
| Nail/tag 12" Elm | S85°W 135.75' | | |

The selected location is accepted by me and is generally accepted by professional surveyors as the best available evidence of the position of the original corner.

C. Description of monument for corner and accessories established to perpetuate locating the position of the corner:

- F-11 Standard Kent County Monument
- | | |
|--------------------------------------|--------------|
| Nail & KC Remon. tag E. side 14" Elm | N20°E 69.83' |
| Nail & KC Remon. tag S. side 30" Ash | N90°E 77.38' |
| "X" in W. end 12" conc. culvert | N10°W 81.65' |
| Nail & KC Remon. tag SE side 12" Elm | S40°W 39.81' |
- C/L gravel road West is North 8'±
On C/L bit. road N-S ± and on tree row East

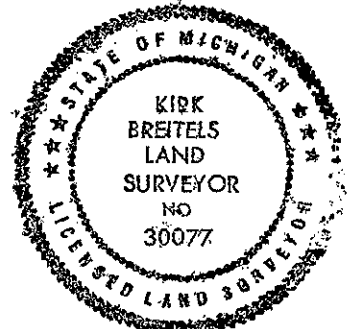

Signed by *Kirk Breitels*
Surveyor's Michigan License No. 30077

Date 3/1/96