

SURVEY & REMONUMENTATION

FEB 14 1997

COMMISSION

KENT COUNTY REMONUMENTATION

LAND CORNER RECORDATION CERTIFICATE
Filing Requirement of Act 74, Mich. P.A. 1970

For corners in

KENT COUNTY

(County)

Located In:

Corner Code #

- | | | |
|------------------------------------|--------------------------|-------------|
| 1. Public Land Survey | T <u>6N</u> R <u>10W</u> | <u>F-12</u> |
| | T _____ R _____ | _____ |
| | T _____ R _____ | _____ |
| | T _____ R _____ | _____ |
| 2. Property Controlling in Section | S _____ T _____ R _____ | _____ |
| | S _____ T _____ R _____ | _____ |
| 3. Miscellaneous Property in Sec. | S _____ T _____ R _____ | _____ |
| | S _____ T _____ R _____ | _____ |

9385

Register of Deeds Stamp & File Number

4. Lot No. _____, Recorded Plat _____
5. Private Claims _____

I, Kirk Breitels, in a field survey on Sept. 18, 1996 do hereby state that under requirements of P.A. 74, Michigan P.A. of 1970, the corner points mentioned in lines 1 and 2 above were in conformance with regulations and rules therefore as required in the current manual of survey instructions of the United States Department of the Interior, Bureau of Land Management or by a decree of a Court of Law and/or that the corner points mentioned in lines 3, 4 and 5 above were in conformance with the rules of the Michigan Board of Land Surveyors or by a Decree of a Court of Law; established, re-established, monumented, recovered, found as expressed below:

NOTE: Not more than 2 corners, all in the same town and range, may be recorded on this certificate.

	A	B	C	D	E	F	G	H	I	J	K	L
1												
2	6		5			4			3		2	1
3												
4	7		8			9			10		11	12
5												
6	10		17			16			15		14	13
7												
8	19		20			21			22		23	24
9												
10	30		29			28			27		26	25
11												
12	31		32			33			34		35	36
13												

A. Description of original monument and accessories and/or subsequent restoration:

- F-12 1831---GLO---Not Set
- 1948-72---Williams & Works---Set/Used Iron at intersection 1/4 lines
12" Elm NE 15.25' 6" Elm SE 12.7' Iron E 33'
- 1973---LCRC #467---Spicer---1" Iron: 1" Iron N90°W 33.00'
CP Pole N85°W 64.38' 6" Maple N20°W 109.38' 4" Elm N35°E 54.30'
- 1973---LCRC #550---VanKooten---Sq. Spike
6" Elm NNE 44.32' CP Pole W 64.42' 8" Maple NNW 109.27'
- 1978---Survey---Exxel Eng.---3/4" Iron
P. Pole E 36.41' 8" Elm NNE 51.57' 12" Ash NNW 110.69'

B. Description of corner evidence found and/or method applied in restoring or reestablishing corner:


- F-12 Found Spike inside 1" Iron Pipe per the following witnesses:
14" Maple N20°W 109.2' Iron Pipe W 33.00'
12" Elm (dead) N35°E 54.4' P. Pole W 64.4'

Said Spike inside 1" Iron Pipe is 4.7' W. (4.73' W. per LCRC #467) and 4.3' S. from intersection of 1/4 lines and agrees with survey measurements of others.

The Spike inside 1" Iron Pipe is accepted by me and is generally accepted by professional surveyors as the best available evidence of the position of the corner.

C. Description of monument for corner and accessories established to perpetuate locating the position of the corner:

- F-12 Set Standard Kent County Monument in place of the Spike and 1" Iron Pipe
- Set Nail & KC Remon. tag W. side CATV Pole S15°E 127.10'
- Set Nail & KC Remon. tag N. side P. Pole S85°E 41.24'
- Set Nail & KC Remon. tag N. side P. Pole N85°W 64.36'
- Set Nail & KC Remon. tag E. side 14" Maple N20°W 109.18'
- Iron Pipe N90°W 33.00'

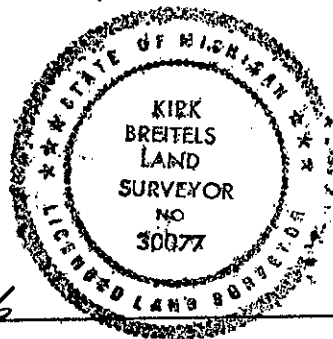

Signed by Kirk Breitels
Surveyor's Michigan License No. 30077

Date 10/11/96

P.A. 345 1990 KENT COUNTY
PEER APPROVED 8/22/96
CHAIRMAN Harvey Huber