

**SURVEY & REMONUMENTATION**

**KENT COUNTY REMONUMENTATION**

FEB 14 1997

COMMISSION

**LAND CORNER RECORDATION CERTIFICATE**  
Filing Requirement of Act 74, Mich. P.A. 1970

For corners in  
**KENT COUNTY**

Located In: Corner Code #

1. Public Land Survey	T <u>6N</u> R <u>10W</u>	<u>F-13</u>
	T <u>   </u> R <u>   </u>	<u>   </u>
	T <u>   </u> R <u>   </u>	<u>   </u>
	T <u>   </u> R <u>   </u>	<u>   </u>
2. Property Controlling in Section	S <u>   </u> T <u>   </u> R <u>   </u>	<u>   </u>
	S <u>   </u> T <u>   </u> R <u>   </u>	<u>   </u>
3. Miscellaneous Property in Sec.	S <u>   </u> T <u>   </u> R <u>   </u>	<u>   </u>
	S <u>   </u> T <u>   </u> R <u>   </u>	<u>   </u>

STATE OF MICHIGAN  
COUNTY OF KENT  
RECEIVED FOR RECORD  
96 MAR 20 AM 8:45  
REG. OF DEEDS  
*[Signature]*

8966

Register of Deeds Stamp & File Number

4. Lot No. \_\_\_\_\_, Recorded Plat \_\_\_\_\_  
5. Private Claims \_\_\_\_\_

I, Kirk Breitels, in a field survey on Feb. 20, 1996 do hereby state that under requirements of P.A. 74, Michigan P.A. of 1970, the corner points mentioned in lines 1 and 2 above were in conformance with regulations and rules therefore as required in the current manual of survey instructions of the United States Department of the Interior, Bureau of Land Management or by a decree of a Court of Law and /or that the corner points mentioned in lines 3, 4 and 5 above were in conformance with the rules of the Michigan Board of Land Surveyors or by a Decree of a Court of Law; established, re-established, monumented, recovered, found as expressed below:

NOTE: Not more than 2 corners, all in the same town and range, may be recorded on this certificate.

	A	B	C	D	E	F	G	H	I	J	K	L	M
1													
2		6		5		4		3		2		1	
3													
4		7		8		9		10		11		12	
5													
6		18		17		16		15		14		13	
7													
8		19		20		21		22		23		24	
9													
10		30		29		28		27		26		25	
11													
12		31		32		33		34		35		36	
13													

A. Description of original monument and accessories and/or subsequent restoration:

F-13	1831	GLO	Mullett	Set Post
	1963	Kent Co. Wit.		Iron
	1973	LCRC #550	VanKooten	3/4" Iron
	1977	LCRC #981	Bonnema	3/4" Iron
	1981	LCRC #1692	Merdzinski	Set Kent County Monument
	1994	LCRC #7124	Bueche	Kent County Monument

P.A. 345 1990 KENT COUNTY  
PEER APPROVED 3/7/96  
CHAIRMAN *[Signature]*

The position of this corner was previously approved by the Kent County Remonumentation Peer Group, monumented by John A. Merdzinski on 22/23/81 and was recorded per LCRC #1692

B. Description of corner evidence found and/or method applied in restoring or reestablishing corner:


F-13 Found standard Kent Co. Mon. (Harrison) per witnesses from above LCRC as set by John A. Merdzinski in place of the 3/4" Iron over a 3/4" Iron over a 3/8" Iron he found. All Irons check with Kent Co. Wit. and LCRC's #550 & #981.

<u>LCRC #1692</u>	<u>LCRC #7124</u>
T.P. N15°W 101.44'	P.P. N65°W 85.78'
Nail/tag Tri. 10" Cherry S40°W 35.25'	Nail/tag P.P. N65°W 85.78' KC Mon. West 73.06'
Nail/tag Dbl. 10" Hickory S20°E 29.46'	Nail/tag Tri. 12" Cherry S40°W 34.97'
NW cor. hse. S15°E 82.73'	Nail/tag Dbl. 14" Hickory S20°E 29.40'
NE cor. hse. fnd. S35°E 97.81'	NW cor. hse. fnd. #6940 S15°E 82.73'
	NE cor. hse. fnd. #6940 S35°E 97.81'

The selected location is accepted by me and is generally accepted by professional surveyors as the best available evidence of the position of the original corner.

C. Description of monument for corner and accessories established to perpetuate locating the position of the corner:

F-13 Standard Kent County Monument	
Nail & KC Remon. tag SW side P. Pole	N65°W 86.07'
Nail & KC Remon. tag NW side Tri. 12" Cherry	S40°W 35.04'
Nail & KC Remon. tag NE side Dbl. 14" Hickory	S20°E 29.45'
NW cor. hse. fnd. (#6940)	S15°E 82.73'
NE cor. hse. fnd. (#6940)	S35°E 97.86'
Kent Co. Mon. (F-1, T5N, R10W)	West 73.15'

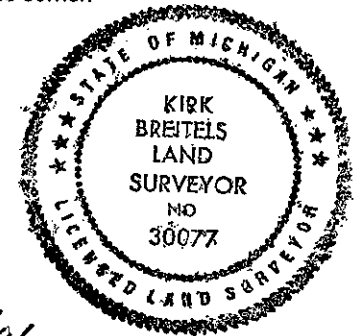

Signed by *[Signature]*  
Surveyor's Michigan License No. 30077

Date 3/1/96