

SURVEY & REMONUMENTATION

FEB 14 1997

COMMISSION

KENT COUNTY REMONUMENTATION

LAND CORNER RECORDATION CERTIFICATE
Filing Requirement of Act 74, Mich. P.A. 1970

REG. OF DEEDS

Lucy J. Board

96 MAR 20 AM 8:46

STATE OF MICHIGAN
COUNTY OF KENT
RECEIVED FOR RECORD

For corners in
KENT COUNTY
(County)

Located In:	Corner Code #
T 6N R 10W	G-2
T R	
T R	
T R	
T R	
S T R	
S T R	
S T R	
S T R	

1. Public Land Survey

2. Property Controlling in Section

3. Miscellaneous Property in Sec.


4. Lot No. _____, Recorded Plat _____
5. Private Claims _____

8967

Register of Deeds Stamp & File Number

I, Kirk Breitels, in a field survey on Feb. 5, 1996 do hereby state that under requirements of P.A. 74, Michigan P.A. of 1970, the corner points mentioned in lines 1 and 2 above were in conformance with regulations and rules therefore as required in the current manual of survey instructions of the United States Department of the Interior, Bureau of Land Management or by a decree of a Court of Law and/or that the corner points mentioned in lines 3, 4 and 5 above were in conformance with the rules of the Michigan Board of Land Surveyors or by a Decree of a Court of Law, established, re-established, monumented, recovered, found as expressed below:

NOTE: Not more than 2 corners, all in the same town and range, may be recorded on this certificate.

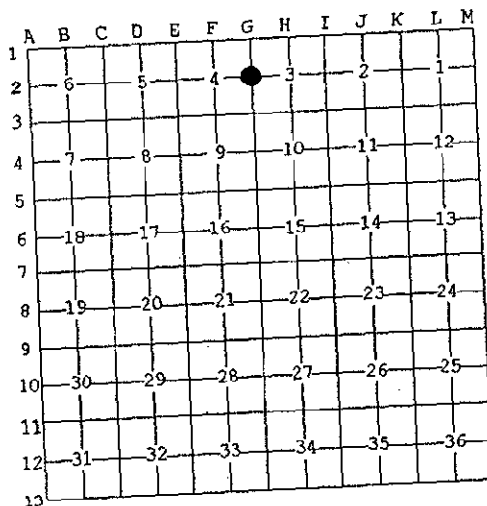

A. Description of original monument and accessories and/or subsequent restoration:

G-2	1831	GLO	Mullett	Set Post
	1939	Kent Co. Wit.		Concrete Monument
	1974	LCRC #634	Spicer	Concrete Monument
	1975	LCRC #850	Nederveld	3/4" Iron in broken concrete
	1981	LCRC #1890	Merdzinski	Set Kent County Monument
	1994	LCRC #7125	Bueche	Kent County Monument

P.A. 345 1990 KENT COUNTY

PEER APPROVED 3/7/96
CHAIRMAN *Hans Huber*

The position of this corner was previously approved by the Kent County Remonumentation Peer Group, monumented by John A. Merdzinski on 6/2/81 and was recorded per LCRC #1890

B. Description of corner evidence found and/or method applied in restoring or reestablishing corner:

G-2 Found standard Kent Co. Mon. (Harrison) per witnesses from above LCRC as set by John A. Merdzinski in place of the Concrete Monument he found. Said Concrete Monument checks with Kent Co. Wit. and LCRC's #634 & #850.

LCRC #1890


Nail/tag P. Pole	S20°W	101.68'	Nail/tag P. Pole	S20°E	101.68'	SW cor. hse. fnd.
Nail/tag P. Pole	N70°E	33.14'	Nail/tag 32" Oak	N15°E	55.86'	S80°E 113.75'
Nail/tag 16" Cedar	N45°E	43.17'	Nail/tag P. Pole	N70°E	33.14'	
Nail/tag 22" Oak	N15°E	56.32'	Nail/tag Tri. 18" Maple	West	61.41'	
SW cor. hse. fnd.	S80°E	113.75'	Nail/tag MBT Pole	N35°W	108.87'	

The selected location is accepted by me and is generally accepted by professional surveyors as the best available evidence of the position of the original corner.

C. Description of monument for corner and accessories established to perpetuate locating the position of the corner:

G-2 Standard Kent County Monument

Nail & KC Remon. tag SW side	P. Pole	S20°E	101.68'
Nail & KC Remon. tag W. side	36" Oak	N15°E	55.92'
Nail & KC Remon. tag S. side	P. Pole	N70°E	33.14'
Nail & KC Remon. tag S. side	Tri. 18" Maple	S90°W	61.41'
Nail & KC Remon. tag NE side	MBT Pole	N35°W	108.90'
SW corner house foundation		S80°E	113.75'
C/L road N-S is	35'± W.		

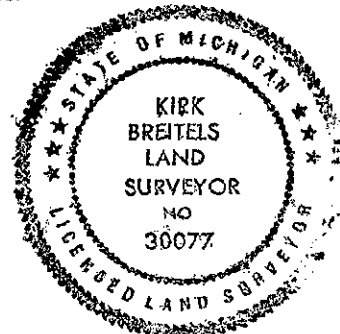

Signed by *Kirk Breitels*
Surveyor's Michigan License No. 30077

Date 3/1/96