KENT	COHNITY	REMONUMENTATION
NEN I	COUNT	REMONOMERINATOR

FEB 1 4 1997

LAND CORNER RECORDATION CERTIFICATE Filing Requirement of Act 74, Mich. P.A. 1970

REG. OF	96 MAR 20	STATE OF I
DEEDS	9 6 9	ARCONO

COMMISSION


KENT COUNTY	Located In:	Corner Code #
(County)		
1. Public Land Survey	T <u>6N</u> R T R T R T R	10W G-4
Property Controlling in Section Miscellaneous Property in Sec.	S TR S TR S TR	

Register of Deeds Stamp & File Number

4. Lot No	Recorded Plat	
5. Private Claims		<u> </u>

Kirk Breitels , in a field survey on Feb. 5 , 19 96 do hereby state that under requirements of P.A. 74, Michigan P.A. of 1970, the corner points mentioned in lines 1 and 2 above were in conformance with regulations and rules therefore as required in the current manual of survey instructions of the United States Department of the Interior, Bureau of Land Management or by a decree of a Court of Law and /or that the corner points mentioned in lines 3, 4 and 5 above were in conformance with the rules of the Michigan Board of Land Surveyors or by a Decree of a Court of Law; established, re-established, monumented, recovered, found as expressed below:

NOTE: Not more than 2 comers, all in the same town and range, may be recorded on this certificate.

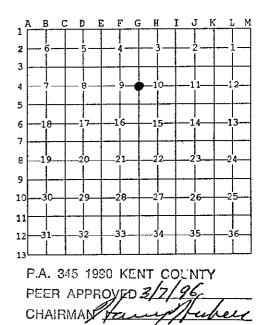

A. Description of original monument and accessories and/or subsequent restoration:

G-4	1831	GLO	Mullett	Set Post	PEER APP
	1939	Kent Co. Wit.		Iron	CHAIRMA
	1973	LCRC #387	Spicer	1" Iron	
	1981	LCRC #1892	Merdzinski	Set Kent County	y Monument
	1994	LCRC #7127	Bueche	Kent County Mo	nument

The position of this corner was previously approved by the Kent County Remonumentation Peer Group, monumented by John A. Merdzinski on 6/2/81 and was recorded per LCRC #1892

B. Description of corner evidence found and/or method applied in restoring or reestablishing corner:

G-4 Found standard Kent Co. Mon. (Harrison) per witnesses from above LCRC as set by John A. Merdzinski in place of the Conc. Mon. with 1" Iron Pipe he found. Said Conc. Mon./Iron Pipe checks with Kent Co. Wit. and LCRC #387.

LCRC #1892 (Nail/tag)		<u>LCRC #7127 (Nail/tag)</u>
14" Elm N30°E 55.07'	24" Cher. N20°W 53.05'	SW cor. hse. #2410 S35°E 119.00'
RR tie fence post	West 33.21'	NW cor. gar. #2410 S80°E 90.50'
SW cor. house #2410	S35°E 119.00'	SE cor. hse. fnd. N75°W 84.82'
NW cor. house #2410	S80°E 90.50'	22" Elm N40°W 53.78' Conc. Mon. W 33'
SE cor. hse. fnd.	N75°W 84.82'	RR tie fence post N90°W 33.45'
The selected location	n is accepted by me and	is generally accepted by professional

surveyors as the best available evidence of the position of the original corner. C. Description of monument for corner and accessories established to perpetuate locating the position of the corner.

G-4 Standard Kent County Monument

Nail & KC Remon. tag S. side RR tie	fence post N90°W	33.
SW corner house #2410	S35°E 119.00'	
NW corner garage house #2410	S80°E 90.53'	
SE corner house foundation	N75°W 84.86'	
Nail & KC Remon. tag SE side 22" Elm	N40°E 53.83'	
Concrete Monument - West 33.06'		
C/L bit. road N-S is East $2.5' \pm \&$ on	fence West	

50'	OF MICH	rig <sub>to</sub>
	KIRK BREITELS	***
	LAND SURVEYOR	***************************************
	30077	
	OLAND SE	

Signed by

Date\_ 3/1/96

30077 Surveyor's Michigan License No.