

SURVEY & REMONUMENTATION

KENT COUNTY REMONUMENTATION

FEB 14 1997

LAND CORNER RECORDATION CERTIFICATE
Filing Requirement of Act 74, Mich. P.A. 1970

COMMISSION

STATE OF MICHIGAN
COUNTY OF KENT
RECEIVED FOR RECORD
96 MAR 20 AM 8:46

REG. OF DEEDS
Lucy Stand

8974

Register of Deeds Stamp & File Number

For corners in
KENT COUNTY
(County)

Located In:	Corner Code #
T 6N R 10W	G-13
T R	
T R	
T R	
T R	
S T R	
S T R	
S T R	
S T R	

- Public Land Survey
- Property Controlling in Section
- Miscellaneous Property in Sec.
- Lot No. _____, Recorded Plat _____
- Private Claims _____

	A	B	C	D	E	F	G	H	I	J	K	L	M
1													
2	6		5		4		3		2		1		
3													
4	7		8		9		10		11		12		
5													
6	18		17		16		15		14		13		
7													
8	19		20		21		22		23		24		
9													
10	30		29		28		27		26		25		
11													
12	31		32		33		34		35		36		
13													

I, Kirk Breitels, in a field survey on Feb. 27, 1996 do hereby state that under requirements of P.A. 74, Michigan P.A. of 1970, the corner points mentioned in lines 1 and 2 above were in conformance with regulations and rules therefore as required in the current manual of survey instructions of the United States Department of the Interior, Bureau of Land Management or by a decree of a Court of Law and/or that the corner points mentioned in lines 3, 4 and 5 above were in conformance with the rules of the Michigan Board of Land Surveyors or by a Decree of a Court of Law, established, re-established, monumented, recovered, found as expressed below:

NOTE: Not more than 2 corners, all in the same town and range, may be recorded on this certificate.

- A. Description of original monument and accessories and/or subsequent restoration:
- | | | | | |
|------|------|---------------|------------|--------------------------|
| G-13 | 1831 | GLO | Mullett | Set Post |
| | | Kent Co. Wit. | | Iron |
| 1977 | | LCRC #981 | Bonnema | 1/2" Iron |
| 1981 | | LCRC #1691 | Merdzinski | Set Kent County Monument |
| 1994 | | LCRC #7136 | Bueche | Kent County Monument |


P.A. 345 1990 KENT COUNTY
PEER APPROVED 3/7/96
CHAIRMAN Harry Huber

The position of this corner was previously approved by the Kent County Remonumentation Peer Group, monumented by John A. Merdzinski on 2/24/81 and was recorded per LCRC #1691

- B. Description of corner evidence found and/or method applied in restoring or reestablishing corner:
- G-13 Found standard Kent Co. Mon. (Harrison) per witnesses from above LCRC as set by John A. Merdzinski in place of the 1/2" Iron he found. Said Iron checks with Kent Co. Wit. and LCRC #981
- LCRC #1691 (Nail/tag in trees) LCRC #7136
 22" Oak N15°W 41.94' 30" Oak N65°W 26.91' same witnesses ±
 12" Ash S70°W 14.80' Iron West 73.57' as LCRC #1691
 8" Oak S30°E 13.94'
 10" Cherry N85°E 15.35'
 8" Ash N60°E 10.68'

The selected location is accepted by me and is generally accepted by professional surveyors as the best available evidence of the position of the original corner.

- C. Description of monument for corner and accessories established to perpetuate locating the position of the corner:
- G-13 Standard Kent County Monument
- | | | | |
|--------------------------------|------------|--------------------------|--------|
| Nail & KC Remon. tag W. side | 26" Oak | N15°W | 41.91' |
| Nail & KC Remon. tag S. side | 34" Oak | N65°W | 26.87' |
| Nail & KC Remon. tag N. side | 14" Ash | S70°W | 14.82' |
| Nail & KC Remon. tag E. side | 12" Oak | S30°E | 13.94' |
| Nail & KC Remon. tag N. side | 14" Cherry | N85°E | 15.48' |
| Nail & KC Remon. tag N. side | 10" Ash | N60°E | 10.75' |
| Kent Co. Mon. (G-1, T5N, R10W) | West | | 73.59' |
| Capped Iron - South | 30.02' | Top bank to River - East | 150'± |
| House #6040 is South | 90'± | | |

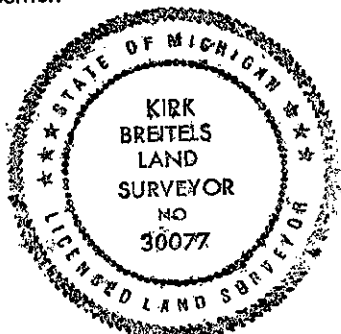

Signed by Kirk Breitels
Surveyor's Michigan License No. 30077

Date 3/1/96