SURVEY & REMONUMENTATION

FEB 1 4 1997

COMMISSION

KENT COUNTY REMONUMENTATION

LAND CORNER RECORDATION CERTIFICATE

Filing Requirement of Act 74, Mich. P.A. 1970

STATE OF MICHIGAN
COUNTY OF KENT
RECEIVED FOR RECORD
96 SEP 13 PM 12: 07
REG. OF DEEDS

9381

Register of Deeds Stamp & File Number

For corners in KENT COUNTY (County)

	Located In:	Corner Code #
1. Public Land Survey	T 6N R 10W	H-1
	T___ R___	
	T___ R___	
	T___ R___	
2. Property Controlling	S___ T___ R___	
in Section	S___ T___ R___	
3. Miscellaneous	S___ T___ R___	
Property in Sec.	S___ T___ R___	

4. Lot No. _____ , Recorded Plat _____

5. Private Claims _____

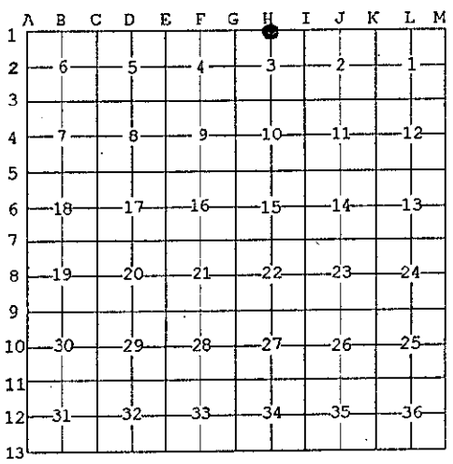

I, Kirk Breitels, in a field survey on June 13, 19 96 do hereby state that under requirements of P.A. 74, Michigan P.A. of 1970, the corner points mentioned in lines 1 and 2 above were in conformance with regulations and rules therefore as required in the current manual of survey instructions of the United States Department of the Interior, Bureau of Land Management or by a decree of a Court of Law and /or that the corner points mentioned in lines 3, 4 and 5 above were in conformance with the rules of the Michigan Board of Land Surveyors or by a Decree of a Court of Law; established, re-established, monumented, recovered, found as expressed below:

NOTE: Not more than 2 corners, all in the same town and range, may be recorded on this certificate.

P.A. 345 1990 KENT COUNTY
PEER APPROVED 8/22/96
CHAIRMAN Fanny Huber

A. Description of original monument and accessories and/or subsequent restoration:

H-1	1831	GLO	Mullett	Not set
		Kent Co. Wit.		1" Iron
	1977	LCRC #973	Merdzinski	1" Iron
	1980	LCRC #1442	Merdzinski	Set Kent County Monument
	1994	LCRC #8059	J. Glaza	Kent County Monument

The position of this corner was previously approved by the Kent County Remonumentation Peer Group, monumented by John A. Merdzinski on 10/22/80 and was recorded per LCRC #1442

B. Description of corner evidence found and/or method applied in restoring or reestablishing corner:

H-1 Found standard Kent Co. Mon. (Harrison) per witnesses from above LCRC as set by John A. Merdzinski in place of the 1" Iron he found. Said Iron checks with LCRC #973

LCRC #1442			LCRC #8059		
Nail/tag Tri. 20" Cherry	S05°E	49.11'	Nail/tag 18" Twin Box Elder	S50°E	14.74'
Nail/tag 12" Oak	West	59.70'	Nail/tag 8" Tree	S25°W	22.47'
Nail/tag 6" Twin Box Elder	N08°E	15.28'	Nail/tag 12" Tree	N65°W	32.40'
Nail/tag 10" Pear Tree	N25°E	57.58'	Nail/tag 10" Tree	N85°E	10.72'
Nail/tag 4" Oak	N60°E	21.55'	Wire fence 1' South		
Nail/tag 14" Tw. Box Elder	S50°E	15.01'			

The selected location is accepted by me and is generally accepted by professional surveyors as the best available evidence of the position of the corner.

C. Description of monument for corner and accessories established to perpetuate locating the position of the corner:

H-1 Standard Kent County Monument

Nail & KC Remon. tag N. side 18" Twin Box Elder	S50°E	14.74'
New Nail & KC Remon. tag E. side 10" Box Elder	S25°W	22.49'
Nail & KC Remon. tag S. side 12" dead tree	N65°W	32.44'
New Nail & KC Remon. tag N. side 12" Cherry	N85°E	10.72'
Kent Co. Monument (H-13, T7N, R10W)	East	63.75'

STATE OF MICHIGAN
KIRK BREITELS
LAND SURVEYOR
NO 30077
LICENSED LAND SURVEYOR

Signed by Kirk Breitels

Date 8/25/96

Surveyor's Michigan License No. 30077

FORM APPROVED BY MICHIGAN STATE BOARD OF PROFESSIONAL SURVEYORS, JAN. 28, 1971
REVISED MAY 14,1975
REVISED JAN., 1983
REVISED OCT., 1995