

**SURVEY & REMONUMENTATION**

**KENT COUNTY REMONUMENTATION**

FEB 14 1997

**LAND CORNER RECORDATION CERTIFICATE**  
Filing Requirement of Act 74, Mich. P.A. 1970

For corners in **COMMISSION**  
**KENT COUNTY**  
(County)

Located In:	Corner Code #
1. Public Land Survey	T 6N R 10W H-2
	T R
	T R
	T R
2. Property Controlling in Section	S T R
	S T R
3. Miscellaneous Property in Sec.	S T R
	S T R

STATE OF MICHIGAN  
COUNTY OF KENT  
RECEIVED FOR RECORD  
96 SEP 13 PM 12:06  
REG. OF DEEDS  
*Eric Spauld*

**9363**

Register of Deeds Stamp & File Number

4. Lot No. \_\_\_\_\_, Recorded Plat \_\_\_\_\_  
5. Private Claims \_\_\_\_\_

I, Kirk Breitels, in a field survey on Aug. 15, 1996 do hereby state that under requirements of P.A. 74, Michigan P.A. of 1970, the corner points mentioned in lines 1 and 2 above were in conformance with regulations and rules therefore as required in the current manual of survey instructions of the United States Department of the Interior, Bureau of Land Management or by a decree of a Court of Law and /or that the corner points mentioned in lines 3, 4 and 5 above were in conformance with the rules of the Michigan Board of Land Surveyors or by a Decree of a Court of Law; established, re-established, monumented, recovered, found as expressed below:

NOTE: Not more than 2 corners, all in the same town and range, may be recorded on this certificate.

	A	B	C	D	E	F	G	H	I	J	K	L	M
1													
2		6		5		4		3		2		1	
3													
4		7		8		9		10		11		12	
5													
6		18		17		16		15		14		13	
7													
8		19		20		21		22		23		24	
9													
10		30		29		28		27		26		25	
11													
12		31		32		33		34		35		36	
13													

A. Description of original monument and accessories and/or subsequent restoration:

H-2 1831--GLO--Not Set 1940--82--Williams & Works--RR Iron fence post  
-----Kent Co. Wit.-----1" Iron  
C.P. WSW 37.10' 6" Oak SE 18.0'  
1977--LCRC #973--Merdzinski--RR rail fence post  
P&T Pole S30°E 3.00' RR rail post S. 50.9' 6" Pine S30°W 59.65'  
1979--Survey--Exxel Eng.--RR Spike  
30" Birch West 42.25' Wood fc. post North 8.05' PP S30°E 3.04'  
1995--Survey--Exxel Eng.--Iron with M & B Cap  
PP SE 2.92 10" Ash NNE 30.11' 10" Pine SW 32.88' C/L 30" Birch W 42'

P.A. 345 1990 KENT COUNTY  
PEER APPROVED 7/25/96  
CHAIRMAN *Harry Huber*


B. Description of corner evidence found and/or method applied in restoring or reestablishing corner:

H-2 Found Iron with M & B Cap. All witnesses from 1995 Exxel survey OK. Witnesses to PP and 30" Birch per 1979 Exxel survey OK ±. Witness to P&T Pole per LCRC #973 OK. Said Iron is 16.6' N. and 9.3' W. from intersection of 1/4 lines. Said Iron agrees with measurements of surveys by Williams & Works, Moore & Bruggink and Exxel Eng. Co.

The Iron with the M & B Cap is accepted by me and is generally accepted by professional surveyors as the best available evidence of the position of the corner.

C. Description of monument for corner and accessories established to perpetuate locating the position of the corner:

H-2 Set Standard Kent County Monument in place of the Iron with the M & B Cap  
PK Nail SW side Power Pole S35°E 2.94'  
Set Nail & KC Remon. tag W. side 12" Ash N10°E 30.10'  
Set Nail & KC Remon. tag NW side 10" Pine N70°E 15.93'  
Set Nail & KC Remon. tag N. side 30" Birch S90°W 42.00'  
Set Nail & KC Remon. tag W. side Twin 14" Ash S00°E 44.07'

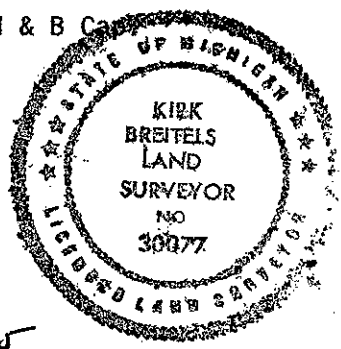

Signed by *Kirk Breitels*  
Surveyor's Michigan License No. 30077

Date 8/26/95