

SURVEY & REMONUMENTATION

FEB 14 1997

KENT COUNTY REMONUMENTATION

COMMISSION LAND CORNER RECORDATION CERTIFICATE
Filing Requirement of Act 74, Mich. P.A. 1970

For corners in

KENT COUNTY

(County)

Located In:

Corner Code #

1. Public Land Survey	T <u>6N</u> R <u>10W</u>	<u>H-3</u>
	T <u> </u> R <u> </u>	<u> </u>
	T <u> </u> R <u> </u>	<u> </u>
	T <u> </u> R <u> </u>	<u> </u>
2. Property Controlling in Section	S <u> </u> T <u> </u> R <u> </u>	<u> </u>
	S <u> </u> T <u> </u> R <u> </u>	<u> </u>
3. Miscellaneous Property in Sec.	S <u> </u> T <u> </u> R <u> </u>	<u> </u>
	S <u> </u> T <u> </u> R <u> </u>	<u> </u>

STATE OF MICHIGAN
COUNTY OF KENT
RECEIVED FOR RECORD

96 JUN -7 AM 8:27

REG. OF DEEDS

Lucy Bond

9155
Register of Deeds Stamp & File Number

4. Lot No. _____, Recorded Plat _____
5. Private Claims _____

I, Kirk Breitels, in a field survey on Mar. 12, 19 96 do hereby state that under requirements of P.A. 74, Michigan P.A. of 1970, the corner points mentioned in lines 1 and 2 above were in conformance with regulations and rules therefore as required in the current manual of survey instructions of the United States Department of the Interior, Bureau of Land Management or by a decree of a Court of Law and/or that the corner points mentioned in lines 3, 4 and 5 above were in conformance with the rules of the Michigan Board of Land Surveyors or by a Decree of a Court of Law; established, re-established, monumented, recovered, found as expressed below:

NOTE: Not more than 2 corners, all in the same town and range, may be recorded on this certificate.

A	B	C	D	E	F	G	H	I	J	K	L	M
1												
2	6	5	4	3	2	1						
3												
4	7	8	9	10	11	12						
5												
6	18	17	16	15	14	13						
7												
8	19	20	21	22	23	24						
9												
10	30	29	28	27	26	25						
11												
12	31	32	33	34	35	36						
13												

A. Description of original monument and accessories and/or subsequent restoration:

H-3	1831	GLO	Mullett	Set Post
		Kent Co. Wit.		Iron
	1979	LCRC #1272	Bonnema	1" Iron
	1982	LCRC #2738	Merdzinski	Set Kent County Monument
	1991	LCRC #6088	Unema	Kent County Monument

P.A. 345 1990 KENT COUNTY
PEER APPROVED 5/30/96
CHAIRMAN *Harry Nubee*

The position of this corner was previously approved by the Kent County Remonumentation Peer Group, monumented by John A. Merdzinski on 2/9/82 and was recorded per LCRC #2738

B. Description of corner evidence found and/or method applied in restoring or reestablishing corner:


H-3 Found standard Kent Co. Mon. (Harrison) per witnesses from above LCRC as set by John A. Merdzinski in place of the Iron he found. Said Iron checks with Kent Co. Wit. and LCRC #1272.

<u>LCRC #2738</u>	<u>LCRC #6088</u>
Nail/tag 18" Pine N65°E 40.98'	Nail/tag 20" Pine N56°E 40.86'
Nail/tag 12" Oak S85°E 41.77'	Nail/tag 12" Oak N90°E 41.79'
Nail/tag 18" Oak North 10.80'	Nail/tag 20" Oak N20°W 10.74'
Nail/tag 14" Pine N65°W 23.14'	Nail/tag 16" Pine N84°W 23.08'
Nail/tag 10" Pine S65°W 17.46'	Nail/tag 10" Pine S35°W 17.41'

The selected location is accepted by me and is generally accepted by professional surveyors as the best available evidence of the position of the original corner.

C. Description of monument for corner and accessories established to perpetuate locating the position of the corner:

H-3	Standard Kent County Monument
New Nail & KC Remon. tag N. side 24" Pine	N56°E 40.91'
New Nail & KC Remon. tag N. side 14" Oak	N90°E 41.79'
New Nail & KC Remon. tag W. side 22" Oak	N20°W 10.74'
New Nail & KC Remon. tag N. side 20" Pine	N84°W 23.09'
New Nail & KC Remon. tag NW side 12" Pine	S35°W 17.45'

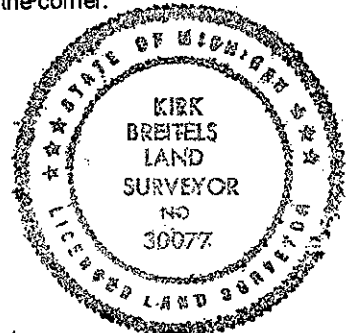

Signed by *Kirk Breitels*
Surveyor's Michigan License No. 30077

Date 4/19/96