

FEB 14 1997

COMMISSION

KENT COUNTY REMONUMENTATION

LAND CORNER RECORDATION CERTIFICATE
Filing Requirement of Act 74, Mich. P.A. 1970

For corners in
KENT COUNTY
(County)

Located In:	Corner Code #
T 6N R 10W	H-6
T ___ R ___	_____
T ___ R ___	_____
T ___ R ___	_____
T ___ R ___	_____
S ___ T ___ R ___	_____
S ___ T ___ R ___	_____
S ___ T ___ R ___	_____
S ___ T ___ R ___	_____

- 1. Public Land Survey
- 2. Property Controlling in Section
- 3. Miscellaneous Property in Sec.

REG. OF DEEDS

9373

96 SEP 13 PM 12:06

STATE OF MICHIGAN
COUNTY OF KENT
RECEIVED FOR RECORD

Register of Deeds Stamp & File Number

- 4. Lot No. _____, Recorded Plat _____
- 5. Private Claims _____

I, Kirk Breitels, in a field survey on July 29, 1996 do hereby state that under requirements of P.A. 74, Michigan P.A. of 1970, the corner points mentioned in lines 1 and 2 above were in conformance with regulations and rules therefore as required in the current manual of survey instructions of the United States Department of the Interior, Bureau of Land Management or by a decree of a Court of Law and /or that the corner points mentioned in lines 3, 4 and 5 above were in conformance with the rules of the Michigan Board of Land Surveyors or by a Decree of a Court of Law; established, re-established, monumented, recovered, found as expressed below:

	A	B	C	D	E	F	G	H	I	J	K	L	M
1													
2	6	5	4	3	2	1							
3													
4	7	8	9	10	11	12							
5													
6	18	17	16	15	14	13							
7													
8	19	20	21	22	23	24							
9													
10	30	29	28	27	26	25							
11													
12	31	32	33	34	35	36							
13													

NOTE: Not more than 2 corners, all in the same town and range, may be recorded on this certificate.

A. Description of original monument and accessories and/or subsequent restoration:

- H-6 1831---GLO---Not Set
- 1928-65---Williams & Works---Set by intersection of 1/4 lines
16" Oak SW 6.18' 12" Cherry E 68.5'
Tw. 8" Oak SE 11.05' 18" Oak NW 16.41'
- 1973---LCRC #619---Spicer---Conc. Mon.
24" Oak S50°E 14.7' 36" Twin Oak S25°E 11.28'
20" Oak N40°W 16.86' NE cor. hse. fnd. S40°W 88.08'
- 1981---Survey---Exxel Eng.---Monument
- 1990---Survey---W. Glaza---Center per LCRC #619

B. Description of corner evidence found and/or method applied in restoring or reestablishing corner:

- H-6 Found Concrete Monument per the following witnesses:
NE cor. hse. fnd. S40°W 88.08' 24" Oak N40°W 16.9'
Tw. 20" Oak S05°E 11.3' 30" Oak S50°E 14.7'

P.A. 345 1990 KENT COUNTY


PEER APPROVED 7/25/96
CHAIRMAN [Signature]

Said Concrete Monument is 0.0' E and 0.3' S. from intersection of 1/4 lines and agrees with adjoining plats and survey measurements of others.

The Concrete Monument is accepted by me and is generally accepted by professional surveyors as the best available evidence of the position of the corner.

C. Description of monument for corner and accessories established to perpetuate locating the position of the corner:

- H-6 Set Standard Kent County Monument in place of the Concrete Monument
- Set Nail & KC Remon. tag SW side 24" Oak N40°W 16.94'
- Set Nail & KC Remon. tag NE side 30" Oak S50°E 14.75'
- Set Nail & KC Remon. tag W. side Tw. 20" Oak S05°E 11.31'
- NE corner house foundation (#7589 Woodvale) S40°W 88.08'
- SE corner brick house (#7588 Leyton) N30°W 68.75'
- SW corner siding house (#7606 Leyton) N30°E 43.45'
- NW corner brick chimney (#7601 Woodvale) S30°E 74.14'

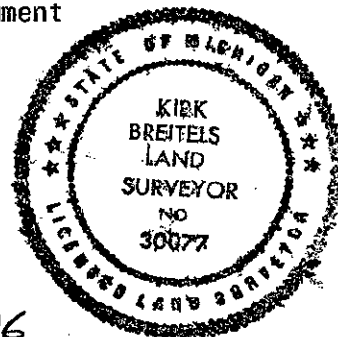

Signed by [Signature]
Surveyor's Michigan License No. 30077

Date 8/25/96