

FEB 14 1997

COMMISSION

KENT COUNTY REMONUMENTATION

LAND CORNER RECORDATION CERTIFICATE
Filing Requirement of Act 74, Mich. P.A. 1970

For corners in

KENT COUNTY

(County)

Located In:

Corner Code #

1. Public Land Survey	T <u>6N</u> R <u>10W</u>	H-9
	T _____ R _____	_____
	T _____ R _____	_____
	T _____ R _____	_____
2. Property Controlling in Section	S _____ T _____ R _____	_____
	S _____ T _____ R _____	_____
3. Miscellaneous Property in Sec.	S _____ T _____ R _____	_____
	S _____ T _____ R _____	_____

STATE OF MICHIGAN
COUNTY OF KENT
RECEIVED FOR RECORD
95 OCT 18 AM 8:19
REG. OF DEEDS
[Signature]
9390

Register of Deeds Stamp & File Number

4. Lot No. _____, Recorded Plat _____
5. Private Claims _____

I, Kirk Breitels, in a field survey on Sept. 16, 1996 do hereby state that under requirements of P.A. 74, Michigan P.A. of 1970, the corner points mentioned in lines 1 and 2 above were in conformance with regulations and rules therefore as required in the current manual of survey instructions of the United States Department of the Interior, Bureau of Land Management or by a decree of a Court of Law and /or that the corner points mentioned in lines 3, 4 and 5 above were in conformance with the rules of the Michigan Board of Land Surveyors or by a Decree of a Court of Law, established, re-established, monumented, recovered, found as expressed below:

NOTE: Not more than 2 corners, all in the same town and range, may be recorded on this certificate.

A	B	C	D	E	F	G	H	I	J	K	L	M
1												
2	6	5	4	3	2	1						
3												
4	7	8	9	10	11	12						
5												
6	10	17	16	15	14	13						
7												
8	19	20	21	22	23	24						
9												
10	30	29	28	27	26	25						
11												
12	31	32	33	34	35	36						
13												

A. Description of original monument and accessories and/or subsequent restoration:

- H-9 1831 GLO Mullett Set Post
- 1929-52 Williams & Works Set/Used cor. midway & on line btw. sec. cor.
- 1964 Williams & Works Reset from previous surveys (1929-1952)
- 1965 Kent Co. Wit. Iron
- 6" Oak NW 148.5' 22" Maple N 234.4' Cl. 10" Ash ENE 421.85'
- 1984 LCRC #3710 Chettleburgh Set Kent County Monument
- 1991 LCRC #6091 Unema Kent County Monument

The position of this corner was previously approved by the Kent County Remonumentation Peer Group, monumented by Thomas Chettleburgh on 12/20/83 and recorded per LCRC #3710

B. Description of corner evidence found and/or method applied in restoring or reestablishing corner:

H-9 Area of corner is in a new golf course. DID NOT FIND Kent Co. Mon. as set by Thomas Chettleburgh in place of the 3/4" Iron Pipe he found. Said Iron Pipe checks with Williams & Works information and Kent Co. Wit.

LCRC #3710 (LCRC #6091 has some of the same witnesses)

22" Maple N05°E 235.51' 34" Maple N09°E 247.59' Multi-Ash N78°E 423.78'
3" Elm S46°W 12.78' 7" Elm S57°W 43.82' 8" Elm N76°W 87.52' 24" Oak N61°W 148.68'
Found one remain. wit. - 30" Oak N61°W 148.68'. Established corner at the intersection of a straight line between the sec. cor. and S61°E 148.68' from the remain. wit. Location fits 1964 WW distance to NW cor. ± 0.2' and distance North to plat cor. ± 0.3'. The selected location is accepted by me and is generally accepted by professional surveyors as the best available evidence of the position of the original corner.


C. Description of monument for corner and accessories established to perpetuate locating the position of the corner:

H-9 Set 1/2" Rerod with "Kent Co. Remon." cap in close cut fringe of golf green at location described above.

- Set Nail & KC Remon. tag NE side 30" Oak N61°W 148.68'
- Set Nail & KC Remon. tag E. side 12" Maple N15°E 139.56'
- Set Nail & KC Remon. tag SE side 15" Ash N55°E 183.61'
- Set Nail & KC Remon. tag N. side 18" Oak S85°E 259.70'
- Set Nail & KC Remon. tag W. side 15" Cherry S20°W 230.34'
- Set Nail & KC Remon. tag N. side 18" Cherry S70°W 187.13'
- Near SE corner golf green is N65°W ± 27' ±
- Most N'ly island in sand trap is S30°W ± 55' ±

Signed by Kirk Breitels
Surveyor's Michigan License No. 30077

Date 10/11/96

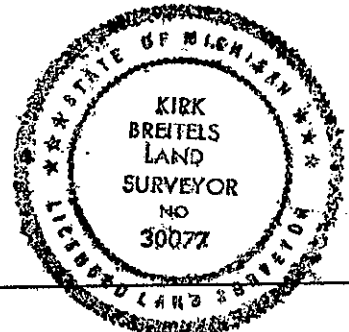

P.A. 345 1990 KENT COUNTY

PEER APPROVED 9/26/96

CHAIRMAN [Signature]