

SURVEY &  
REMONUMENTATION

FEB 14 1997

COMMISSION

KENT COUNTY REMONUMENTATION  
LAND CORNER RECORDATION CERTIFICATE  
Filing Requirement of Act 74, Mich. P.A. 1970

For corners in  
KENT COUNTY  
(County)

Located In:	Corner Code #
T6N R 10W	H-10
T R	
T R	
T R	
S T R	
S T R	
S T R	
S T R	

1. Public Land Survey

2. Property Controlling in Section

3. Miscellaneous Property in Sec.

4. Lot No. \_\_\_\_\_, Recorded Plat \_\_\_\_\_  
5. Private Claims \_\_\_\_\_

I, Kirk Breitels, in a field survey on Sept. 30, 1996 do hereby state that under requirements of P.A. 74, Michigan P.A. of 1970, the corner points mentioned in lines 1 and 2 above were in conformance with regulations and rules therefore as required in the current manual of survey instructions of the United States Department of the Interior, Bureau of Land Management or by a decree of a Court of Law and/or that the corner points mentioned in lines 3, 4 and 5 above were in conformance with the rules of the Michigan Board of Land Surveyors or by a Decree of a Court of Law; established, re-established, monumented, recovered, found as expressed below:

NOTE: Not more than 2 corners, all in the same town and range, may be recorded on this certificate.

	A	B	C	D	E	F	G	H	I	J	K	L
1												
2	6		5		4		3		2		1	
3												
4	7		8		9		10		11		12	
5												
6	10		17		16		15		14		13	
7												
8	19		20		21		22		23		24	
9												
10	30		29		28		27		26		25	
11												
12	31		32		33		34		35		36	
13												

A. Description of original monument and accessories and/or subsequent restoration:

- H-10 1831---GLO---Not Set
- 1949---Williams & Works---Computed Center
- 1952-74---Williams & Works---Set/Used "T" Iron on E-W 1/4  
PP SE 70.4' 30" Oak NNE 28.76' Mon. S 42.5' & 49.95'
- 1972---LCRC #268---VanKooten---Round Iron  
CP Pole SE 71.22' Mon. S 42.53 & 50.13' 30" Maple NE 30.63'
- 1984---Survey---Exxel Eng.---Round Iron per LCRC #268
- 1994---Survey---Chettleburgh---"T" Iron - wits. same as LCRC #268

B. Description of corner evidence found and/or method applied in restoring or reestablishing corner:


- H-10 Found "T" Iron over a 1" Iron Pipe per the following witnesses:  
PK in side PP SE 71.23' (70.5' to nail in face)  
C/L 40" Maple NE 30.4'  
Conc. Mon. to South 42.45' and 49.77'

Said "T" Iron is 2.0' E. and 0.1' N. from intersection of 1/4 lines and agrees with survey measurements of others.

The "T" Iron is accepted by me and is generally accepted by professional surveyors as the best available evidence of the position of the corner.

C. Description of monument for corner and accessories established to perpetuate locating the position of the corner:

- H-10 Set Standard Kent County Monument over the Iron Pipe in place of the "T" Iron
- Set Nail & KC Remon. tag SE side 40" Maple N40°E 30.34'
- Set Nail & KC Remon. tag NE side P. Pole S45°E 71.23'
- Set Nail & KC Remon. tag W. side Guy Pole S05°E 44.83'
- Set Nail & KC Remon. tag S. side 40" Maple N65°W 79.00'
- NE corner brick wing wall to house S25°W 94.18'
- C/L E-W asph. rd. is S. 9.5'±

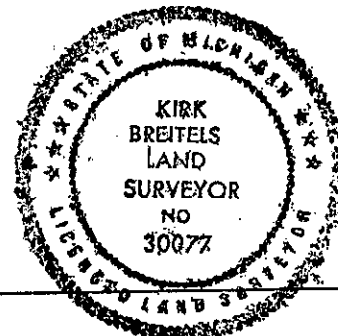

Signed by Kirk Breitels  
Surveyor's Michigan License No. 30077

Date 10/11/96

P.A. 345 1990 KENT COUNTY

PEER APPROVED 9/26/96

CHAIRMAN Harry Huber