

**SURVEY & REMONUMENTATION**

FEB 14 1997

COMMISSION

**KENT COUNTY REMONUMENTATION**

**LAND CORNER RECORDATION CERTIFICATE**  
Filing Requirement of Act 74, Mich. P.A. 1970

For corners in  
**KENT COUNTY**  
(County)

Located In:	Corner Code #
T 6N R 10W	I-6
T R	
T R	
T R	
T R	
S T R	
S T R	
S T R	
S T R	

- 1. Public Land Survey
- 2. Property Controlling in Section
- 3. Miscellaneous Property in Sec.

4. Lot No. \_\_\_\_\_, Recorded Plat \_\_\_\_\_  
5. Private Claims \_\_\_\_\_

I, Kirk Breitels, in a field survey on Feb. 12, 1996 do hereby state that under requirements of P.A. 74, Michigan P.A. of 1970, the corner points mentioned in lines 1 and 2 above were in conformance with regulations and rules therefore as required in the current manual of survey instructions of the United States Department of the Interior, Bureau of Land Management or by a decree of a Court of Law and/or that the corner points mentioned in lines 3, 4 and 5 above were in conformance with the rules of the Michigan Board of Land Surveyors or by a Decree of a Court of Law; established, re-established, monumented, recovered, found as expressed below:

NOTE: Not more than 2 corners, all in the same town and range, may be recorded on this certificate.

**A. Description of original monument and accessories and/or subsequent restoration:**

I-6	1831	GLO	Mullett	Set Post Stone
		Kent Co. Wit.		3/4" Iron in Mon. Box
	1972	LCRC #120	Chambers	Mon. Box
	1977	LCRC #1233	Byl	Set Kent County Monument in Mon. Box
	1981	LCRC #1597	Merdzinski	Kent County Monument
	1991	LCRC #6074	Unema	

The position of this corner was previously approved by the Kent County Remonumentation Peer Group, monumented by John A. Merdzinski on 2/18/81 and was recorded per LCRC #1597

**B. Description of corner evidence found and/or method applied in restoring or reestablishing corner:**

I-6 Found standard Kent Co. Mon. (Harrison) per witnesses from above LCRC as set by John A. Merdzinski in place of the 3/4" Iron he found inside a Mon. Box with stones and clay tile. All check with Kent Co. Wit. and LCRC's #210, #1233.  
LCRC #1597 (Nail/tag in trees)  
28" Oak N65°W 32.18' 12" Elm N80°E 23.25' 14" Elm N84°E 23.15' 12" Pine N26°W 49.15'  
36" Box Elder S35°W 49.85' 9" Hickory S51°E 37.11'  
18" Hickory S85°W 36.30' 10" Maple N54°E 52.24'  
8" Maple N50°E 52.27' 22" Hickory S89°W 30.28'  
6" Box Elder S30°E 34.68' 40" Box Elder S40°W 50.24'

The selected location is accepted by me and is generally accepted by professional surveyors as the best available evidence of the position of the original corner.

**C. Description of monument for corner and accessories established to perpetuate locating the position of the corner:**


I-6	Standard Kent County Monument		
	Nail & KC Remon. tag SW side	12" Hickory	S51°E 37.24'
	Nail & KC Remon. tag N. side	16" Elm	N84°E 23.21'
	Nail & KC Remon. tag NW side	12" Maple	N54°E 52.30'
	Nail & KC Remon. tag SW side	14" W. Pine	N26°W 49.15'
	Nail & KC Remon. tag N. side	26" Hickory	S89°W 36.28'
	Nail & KC Remon. tag NW side	44" Box Elder	S40°W 50.24'
	C/L Buttrick Ave. is West 3.5'±		
	On E-W tree row		



Signed by Kirk Breitels  
Surveyor's Michigan License No. 30077

Date 3/1/96

STATE OF MICHIGAN  
COUNTY OF KENT  
RECEIVED FOR RECORD  
96 MAR 20 AM 8:46  
REG. OF DEEDS  
8982  
Register of Deeds Stamp & File Number

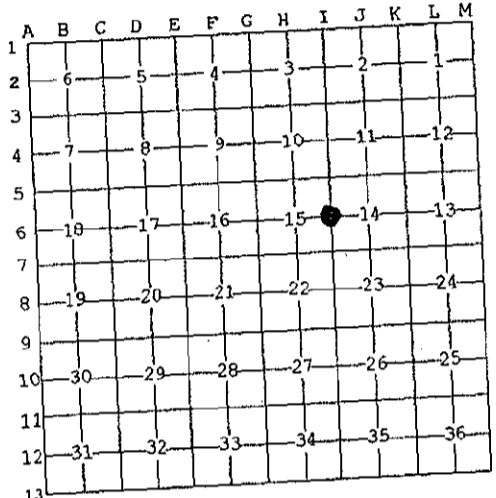

P.A. 345 1990 KENT COUNTY  
PEER APPROVED 3/7/96  
CHAIRMAN Harry Kuper