

YN

SURVEY & REMONUMENTATION

KENT COUNTY REMONUMENTATION

FEB 14 1997

LAND CORNER RECORDATION CERTIFICATE
Filing Requirement of Act 74, Mich. P.A. 1970

COMMISSION

For corners in

KENT COUNTY

(County)

Located In:

Corner Code #

1. Public Land Survey	T6N R 10W	I-7
	T R	
	T R	
	T R	
	T R	
2. Property Controlling in Section	S T R	
	S T R	
3. Miscellaneous Property in Sec.	S T R	
	S T R	

STATE OF MICHIGAN
COUNTY OF KENT
RECEIVED FOR RECORD

96 JUN -7 AM 8:27

REG. OF DEEDS

W. J. ...


9157

Register of Deeds Stamp & File Number

4. Lot No. _____, Recorded Plat _____
5. Private Claims _____

I, Kirk Breitels, in a field survey on Apr. 3, 1996 do hereby state that under requirements of P.A. 74, Michigan P.A. of 1970, the corner points mentioned in lines 1 and 2 above were in conformance with regulations and rules therefore as required in the current manual of survey instructions of the United States Department of the Interior, Bureau of Land Management or by a decree of a Court of Law and/or that the corner points mentioned in lines 3, 4 and 5 above were in conformance with the rules of the Michigan Board of Land Surveyors or by a Decree of a Court of Law; established, re-established, monumented, recovered, found as expressed below:

NOTE: Not more than 2 corners, all in the same town and range, may be recorded on this certificate.

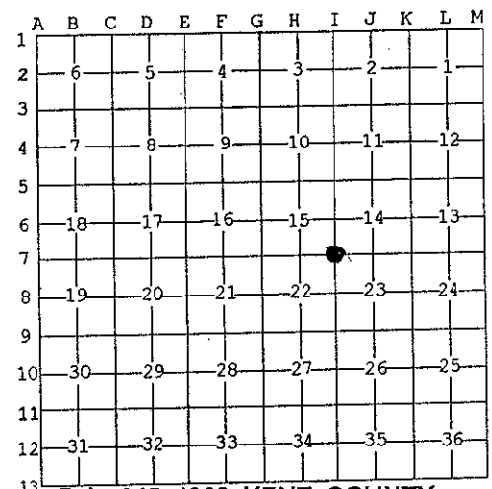

A. Description of original monument and accessories and/or subsequent restoration:

I-7	1831	GLO	Mullett	Set Post	
	1956	Kent Co. Wit.		1/2" Iron - Mon. Box	CHAIRMAN <i>W. J. ...</i>
	1972	LCRC #120	Chambers	3/4" Iron in Mon. Box	
	1975	LCRC #854	Nederveld	1" Round Iron in Mon. Box	
	1978	LCRC #1237	Byl	Iron in Mon. Box	
	1981	LCRC #1598	Merdzinski	Set Kent County Monument in Mon. Box	
	1991	LCRC #6075	Unema	Kent County Monument in Mon. Box	

The position of this corner was previously approved by the Kent County Remonumentation Peer Group, monumented by John A. Merdzinski on 2/18/81 and was recorded per LCRC #1598

B. Description of corner evidence found and/or method applied in restoring or reestablishing corner:


I-7 Found standard Kent Co. Mon. (Harrison) per witnesses from above LCRC as set by John A. Merdzinski in place of the 3/4" Iron Pipe over a 1/2" Iron Pipe he found. Both Irons check with Kent Co. Wit. and LCRC's #120, #854, #1237

<u>LCRC #1598 (Nail/tag in trees-poles)</u>	<u>LCRC #6075</u>	
SW cor. conc. base Tel. Box N80°E 108.55'	Nail/tag 20" Oak	S15°E 99.62'
18" Oak S35°E 46.13'	18" Oak S15°E 99.80'	Nail/tag 20" Oak
16" Pine S75°W 93.90'	Nail/tag 22" Pine	S39°E 46.35'
T. Pole N50°W 46.00'	Nail/tag P. Pole	S69°W 93.87'
P. Pole S60°W 82.18'	SW cor. base T. Box N80°W 108.50'	S60°W 82.17'

The selected location is accepted by me and is generally accepted by professional surveyors as the best available evidence of the position of the original corner.

C. Description of monument for corner and accessories established to perpetuate locating the position of the corner:

I-7 Standard Kent County Monument in Mon. Box		
Nail & KC Remon. tag W. side 24" Oak	S15°E	99.62'
New Nail & KC Remon. tag SW side 24" Oak	S39°E	46.34'
Nail & KC Remon. tag N. side 24" Pine	S69°W	93.87'
Nail & KC Remon. tag S. side P. Pole	S60°W	82.17'
Set Nail & KC Remon. tag E. side P. Pole	N30°W	136.17'
On C/L 36th St.		
C/L Buttrick is 1.5'± West		

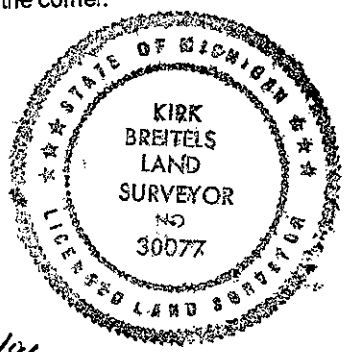

Signed by *Kirk Breitels*
Surveyor's Michigan License No. 30077

Date 4/17/96