

FEB 14 1997

COMMISSION

KENT COUNTY REMONUMENTATION

LAND CORNER RECORDATION CERTIFICATE
Filing Requirement of Act 74, Mich. P.A. 1970

For corners in
KENT COUNTY
(County)

Located In:	Corner Code #
T <u>6N</u> R <u>10W</u>	<u>I-8</u>
T _____ R _____	_____
T _____ R _____	_____
T _____ R _____	_____
T _____ R _____	_____
S _____ T _____ R _____	_____
S _____ T _____ R _____	_____
S _____ T _____ R _____	_____
S _____ T _____ R _____	_____

1. Public Land Survey

2. Property Controlling in Section

3. Miscellaneous Property in Sec.

4. Lot No. _____, Recorded Plat _____
5. Private Claims _____

STATE OF MICHIGAN
COUNTY OF KENT
RECEIVED FOR RECORD

96 JUN -7 AM 8:27

REG. OF DEEDS

W. J. ...

9158

Register of Deeds Stamp & File Number

I, Kirk Breitels, in a field survey on Apr. 3, 1996 do hereby state that under requirements of P.A. 74, Michigan P.A. of 1970, the corner points mentioned in lines 1 and 2 above were in conformance with regulations and rules therefore as required in the current manual of survey instructions of the United States Department of the Interior, Bureau of Land Management or by a decree of a Court of Law and /or that the corner points mentioned in lines 3, 4 and 5 above were in conformance with the rules of the Michigan Board of Land Surveyors or by a Decree of a Court of Law; established, re-established, monumented, recovered, found as expressed below:

NOTE: Not more than 2 corners, all in the same town and range, may be recorded on this certificate.

	A	B	C	D	E	F	G	H	I	J	K	L	M
1													
2	6		5		4		3		2		1		
3													
4	7		8		9		10		11		12		
5													
6	18		17		16		15		14		13		
7													
8	19		20		21		22		23		24		
9													
10	30		29		28		27		26		25		
11													
12	31		32		33		34		35		36		
13													

A. Description of original monument and accessories and/or subsequent restoration:

I-8	1831	GLO	Mullett	Set Post
	1948	Kent Co. Wit.		Iron
	1977	LCRC #1077	Bonnema	3/4" Solid Iron
	1977	LCRC #1102	Glaza	1" Iron Rod
	1978	LCRC #1237	Byl	1" Iron
	1982	LCRC #2740	Merdzinski	Set Kent County Monument
	1991	LCRC #6076	Unema	Kent County Monument

P.A. 345 1990 KENT COUNTY.

PEER APPROVED 5/30/96
CHAIRMAN *Harry Huber*

The position of this corner was previously approved by the Kent County Remonumentation Peer Group, monumented by John A. Merdzinski on 2/22/82 and was recorded per LCRC #2740

B. Description of corner evidence found and/or method applied in restoring or reestablishing corner:


I-8 Found Kent Co. Mon. (Harrison) per witnesses from above LCRC as set by John A. Merdzinski in place of the 1 1/2" Iron (1.2' deep) and Stones he found. Said Iron check with Kent Co. Wit. Iron per LCRC's #1077, #1102, #1237 checks ± 0.15' of 1 1/2" Iron

LCRC #2740	LCRC #6076
Nail/tag 40" Oak	S80°E 27.35' Nail/tag T. Pole stump S72°W 31.32'
Nail/tag 6" Tw. Hickory	N30°E 52.48' Nail/tag 38" Oak S78°E 27.34'
Nail/tag 12" Apple	N35°W 72.50' Nail/tag 16" Apple N36°W 72.51'
Nail/tag T. Pole	S70°W 31.33' Nail/tag 7" Tw. Hickory N31°E 52.41'
C/L 4" steel fc. post	West 30.25' Nail/tag 6" Hickory S37°E 63.25'

The selected location is accepted by me and is generally accepted by professional surveyors as the best available evidence of the position of the original corner.

C. Description of monument for corner and accessories established to perpetuate locating the position of the corner:

I-8 Standard Kent County Monument		
Nail & KC Remon. tag N. side T. Pole stump	S72°W	31.37'
Nail & KC Remon. tag S. side 40" Oak	S78°E	27.34'
Nail & KC Remon. tag NW side 8" Tw. Hickory	N31°E	52.41'
Nail & KC Remon. tag NE side 16" Apple	N36°W	72.51'
Nail & KC Remon. tag NE side 6" Hickory	S37°E	63.25'
C/L pavement is 1.1' S. of corner		
Fence to E. is 1' S. of corner		

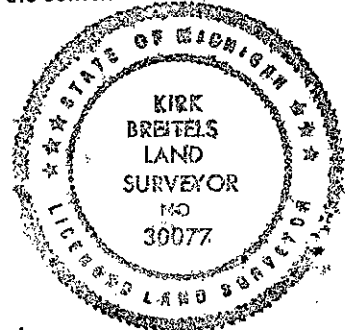

Signed by *Kirk Breitels*
Surveyor's Michigan License No. 30077

Date 4/19/96