

FEB 14 1997

**KENT COUNTY REMONUMENTATION**

**LAND CORNER RECORDATION CERTIFICATE**  
Filing Requirement of Act 74, Mich. P.A. 1970

For corners in  
**KENT COUNTY**  
(County)

Located In:	Corner Code #
T6N R 10W	I-11
T R	
T R	
T R	
S T R	
S T R	
S T R	
S T R	

- 1. Public Land Survey \*
- 2. Property Controlling in Section
- 3. Miscellaneous Property in Sec.

4. Lot No. \_\_\_\_\_, Recorded Plat \_\_\_\_\_  
5. Private Claims \_\_\_\_\_

I, Kirk Breitels, in a field survey on Apr. 2, 1996 do hereby state that under requirements of P.A. 74, Michigan P.A. of 1970, the corner points mentioned in lines 1 and 2 above were in conformance with regulations and rules therefore as required in the current manual of survey instructions of the United States Department of the Interior, Bureau of Land Management or by a decree of a Court of Law and /or that the corner points mentioned in lines 3, 4 and 5 above were in conformance with the rules of the Michigan Board of Land Surveyors or by a Decree of a Court of Law; established, re-established, monumented, recovered, found as expressed below:

NOTE: Not more than 2 corners, all in the same town and range, may be recorded on this certificate.

STATE OF MICHIGAN  
COUNTY OF KENT  
RECEIVED FOR RECORD

96 JUN -7 AM 8:27

REG. OF DEEDS

*Lucy St. Grand*

**9159**

Register of Deeds Stamp & File Number

	A	B	C	D	E	F	G	H	I	J	K	L	M
1													
2	6	5	4	3	2	1							
3													
4	7	8	9	10	11	12							
5													
6	18	17	16	15	14	13							
7													
8	19	20	21	22	23	24							
9													
10	30	29	28	27	26	25							
11													
12	31	32	33	34	35	36							
13													

A. Description of original monument and accessories and/or subsequent restoration:

Date	Monument	Accessories	Restoration
I-11 1831	GLO	Mullett	Set Post
1970	Kent Co. Wit.		Iron/Stone
1972	LCRC #122	Chmabers	2" Iron
1980	LCRC #1428	Merdzinski	Set Kent County Monument
1991	LCRC #6079	Unema	Kent County Monument

P.A. 345 1990 KENT COUNTY  
PEER APPROVED 5/30/96  
CHAIRMAN *Harry Stuber*

The position of this corner was previously approved by the Kent County Remonumentation Peer Group, monumented by John A. Merdzinski on 10/20/80 and was recorded per LCRC #1428

B. Description of corner evidence found and/or method applied in restoring or reestablishing corner:


I-11 Found standard Kent Co. Mon. (Harrison) per witnesses from above LCRC as set by John A. Merdzinski in place of the 2 1/2" Iron over a "T" Iron and Stone he found. Said checks with Kent Co. Wit. and LCRC #122.

LCRC #1428 (Nail/tag in trees & pole)	LCRC #6079	Angle	Distance
24" Hickory	Nail/tag 32" Oak	S70°E	48.78'
40" Oak	Nail/tag 14" Oak	S15°W	87.28'
14" Oak	Nail/tag 24" Twin Oak	S18°E	85.24'
Tw. 24" Oak	Nail/tag 40" Oak	N12°W	62.01'
P. Pole	Nail/tag P. Pole	S87°W	23.35'

The selected location is accepted by me and is generally accepted by professional surveyors as the best available evidence of the position of the original corner.

C. Description of monument for corner and accessories established to perpetuate locating the position of the corner.

Monument	Angle	Distance
I-11 Standard Kent County Monument	S70°E	48.81'
Nail & KC Remon. tag N. side 34" Oak	S15°W	87.32'
Nail & KC Remon. tag E. side 16" Oak	S18°E	85.36'
Nail & KC Remon. tag W. side 24" Twin Oak	N12°W	62.04'
Nail & KC Remon. tag E. side 42" Oak	S87°W	23.30'
Nail & KC Remon. tag N. side P. Pole	N10°E	121.81'
Nail & KC Remon. tag W. side 28" Hickory		
C/L 52nd. St. is North 18'±		
C/L Buttrick Ave. is East 4'±		

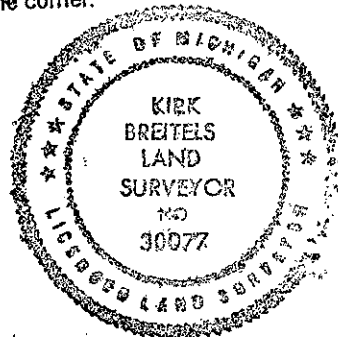

Signed by *Kirk Breitels*  
Surveyor's Michigan License No. 30077

Date 4/19/96