

FEB 14 1997

COMMISSIONER

KENT COUNTY REMONUMENTATION

LAND CORNER RECORDATION CERTIFICATE
Filing Requirement of Act 74, Mich. P.A. 1970

For corners in
KENT COUNTY
(County)

Located In:	Corner Code #
T <u>6N</u> R <u>10W</u>	<u>I-12</u>
T ___ R ___	_____
T ___ R ___	_____
T ___ R ___	_____
T ___ R ___	_____
S ___ T ___ R ___	_____
S ___ T ___ R ___	_____
S ___ T ___ R ___	_____
S ___ T ___ R ___	_____

- 1. Public Land Survey
- 2. Property Controlling in Section
- 3. Miscellaneous Property in Sec.

4. Lot No. _____, Recorded Plat _____
 5. Private Claims _____

I, Kirk Breitels, in a field survey on Apr. 2, 1996 do hereby state that under requirements of P.A. 74, Michigan P.A. of 1970, the corner points mentioned in lines 1 and 2 above were in conformance with regulations and rules therefore as required in the current manual of survey instructions of the United States Department of the Interior, Bureau of Land Management or by a decree of a Court of Law and/or that the corner points mentioned in lines 3, 4 and 5 above were in conformance with the rules of the Michigan Board of Land Surveyors or by a Decree of a Court of Law; established, re-established, monumented, recovered, found as expressed below:

NOTE: Not more than 2 corners, all in the same town and range, may be recorded on this certificate.

STATE OF MICHIGAN
COUNTY OF KENT
RECEIVED FOR RECORD

96 JUN -7 AM 8:27

REG. OF DEEDS

9160

Register of Deeds Stamp & File Number

A	B	C	D	E	F	G	H	I	J	K	L	M
1												
2	6		5		4		3		2		1	
3												
4	7		8		9		10		11		12	
5												
6	18		17		16		15		14		13	
7												
8	19		20		21		22		23		24	
9												
10	30		29		28		27		26		25	
11												
12	31		32		33		34	●	35		36	
13												

A. Description of original monument and accessories and/or subsequent restoration:

I-12	1831	GLO	Mullett	Set Post	P.A. 345 1990 KENT COUNTY
		Kent Co. Wit.		Iron	PEER APPROVED <u>5/30/96</u>
	1973	LCRC #604	VanKooten	1" Solid Iron	CHAIRMAN <u>Harrison</u>
	1982	LCRC #2743	Merdzinski	Set Kent County Monument	
	1991	LCRC #6080	Unema	Kent County Monument	

The position of this corner was previously approved by the Kent County Remonumentation Peer Group, monumented by John A. Merdzinski on 2/5/82 and was recorded per LCRC #2743

B. Description of corner evidence found and/or method applied in restoring or reestablishing corner:


I-12 Found standard Kent Co. Mon. (Harrison) per witnesses from above LCRC as set by John A. Merdzinski in place of the 1" Iron he found. Said Iron checks with Kent Co. Wit. and LCRC #604.

LCRC #2743	LCRC #6080 (Nail/tag in trees)
Nail/tag 6" Oak	S25°E 63.46' 26" W. Cherry N64°E 43.19'
Nail/tag 10" Oak	S40°W 35.85' 22" Twin Oak S75°E 28.62'
Nail/tag 10" Oak	S80°W 31.15' 8" Oak S15°E 63.46' 13" Oak S34°W 35.72'
Nail/tag 8" Hickory	N45°E 32.13' 12" Twin Oak S80°W 31.07'
Nail/tag 18" Twin Oak	S85°E 28.60' 12" Hickory N60°E 32.16'

The selected location is accepted by me and is generally accepted by professional surveyors as the best available evidence of the position of the original corner.

C. Description of monument for corner and accessories established to perpetuate locating the position of the corner:

I-12 Standard Kent County Monument	
Nail & KC Remon. tag NW side 28" W. Cherry	N64°E 42.91'
Nail & KC Remon. tag S. side Twin 24" Oak	S75°E 28.66'
Nail & KC Remon. tag SW side 10" Oak	S15°E 63.49'
New Nail & KC Remon. tag SE side 15" Oak	S34°W 35.73'
Nail & KC Remon. tag S. side 14" Twin Oak	S80°W 31.13'
Nail & KC Remon. tag SE side 14" Hickory	N60°E 32.20'
Corner is 2' W. of C/L grav. rd. & on tree & fence line to E.	
C/L tree line to W. is 5' ± N. of corner	

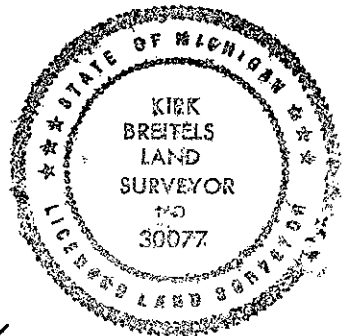

Signed by Kirk Breitels
 Surveyor's Michigan License No. 30077

Date 4/19/96