

**SURVEY & REMONUMENTATION**

FEB 14 1997

**KENT COUNTY REMONUMENTATION**

**COMMISSION**

**LAND CORNER RECORDATION CERTIFICATE**  
Filing Requirement of Act 74, Mich. P.A. 1970

For corners in

KENT COUNTY

(County)

Located In:

Corner Code #

1. Public Land Survey	T <u>6N</u> R <u>10W</u>	<u>I-13</u>
	T ___ R ___	_____
	T ___ R ___	_____
	T ___ R ___	_____
2. Property Controlling in Section	S ___ T ___ R ___	_____
	S ___ T ___ R ___	_____
3. Miscellaneous Property in Sec.	S ___ T ___ R ___	_____
	S ___ T ___ R ___	_____

REG. OF DEEDS

*Handwritten signature*

96 JUN -7 AM 8:27

STATE OF MICHIGAN  
COUNTY OF KENT  
RECEIVED FOR RECORD

**9161**

Register of Deeds Stamp & File Number

4. Lot No. \_\_\_\_\_, Recorded Plat \_\_\_\_\_  
5. Private Claims \_\_\_\_\_

I, Kirk Breitels, in a field survey on Apr. 2, 1996 do hereby state that under requirements of P.A. 74, Michigan P.A. of 1970, the corner points mentioned in lines 1 and 2 above were in conformance with regulations and rules therefore as required in the current manual of survey instructions of the United States Department of the Interior, Bureau of Land Management or by a decree of a Court of Law and/or that the corner points mentioned in lines 3, 4 and 5 above were in conformance with the rules of the Michigan Board of Land Surveyors or by a Decree of a Court of Law; established, re-established, monumented, recovered, found as expressed below:

NOTE: Not more than 2 corners, all in the same town and range, may be recorded on this certificate.

A	B	C	D	E	F	G	H	I	J	K	L	M
1												
2	6		5		4		3		2		1	
3												
4	7		8		9		10		11		12	
5												
6	18		17		16		15		14		13	
7												
8	19		20		21		22		23		24	
9												
10	30		29		28		27		26		25	
11												
12	31		32		33		34		35		36	
13												

P.A. 345 1990 KENT COUNTY

PEER APPROVED 5/30/96

CHAIRMAN Henry Huber  
E. of I-1, T5N, R10W  
Set Post  
Set "T" Iron 40.3' West  
Set Kent County Monument  
Kent County Monument

A. Description of original monument and accessories and/or subsequent restoration:

I-13	1831	GLO	Mullett	Set Post
	1974	LCRC #660	Spicer	Set "T" Iron 40.3' West
	1980	LCRC #1425	Merdzinski	Set Kent County Monument
	1991	LCRC #6081	Unema	Kent County Monument

The position of this corner was previously approved by the Kent County Remonumentation Peer Group, monumented by John A. Merdzinski on 10/16/80 and was recorded per LCRC #1425

B. Description of corner evidence found and/or method applied in restoring or reestablishing corner:


I-13 Found Kent Co. Mon. (Harrison) per wit. from above LCRC, set by John A. Merdzinski in place of the "T" Iron he found over Stones. "T" Iron checks with LCRC #660.

<u>LCRC #1425</u>	<u>LCRC #6081</u>
Nail/tag Tw. 18" Oak N80°W 94.45'	Nail/tag Twin 24" Oak N80°W 94.33'
Nail/tag 30" Oak N28°E 44.63'	Nail/tag 36" Oak N33°E 44.67'
Nail/tag P. Pole S75°E 69.24'	Nail/tag P. Pole S70°E 69.25'
Nail/tag 30" Oak S20°W 25.03'	Nail/tag P. Pole N68°E 74.31'
Nail/tag 28" Oak N32°W 115.38'	Nail/tag 46" Oak N65°W 41.72'
SE cor. hse. fnd. N62°W 96.22'	KC Mon. (I-1, 5-10) West 40.22'

The selected location is accepted by me and is generally accepted by professional surveyors as the best available evidence of the position of the original corner.

C. Description of monument for corner and accessories established to perpetuate locating the position of the corner.

I-13 Standard Kent County Monument	
Nail & KC Remon. tag S. side Twin 26" Oak	N80°W 94.38'
New Nail & KC Remon. tag NW side 40" Oak	N33°E 44.72'
Nail & KC Remon. tag SW side P. Pole	S70°E 69.32'
Nail & KC Remon. tag NW side P. Pole	N68°E 74.38'
Nail & KC Remon. tag N. side 46" Oak	N65°W 41.74'
Nail & KC Remon. tag W. side 26" Oak	S10°W 94.65'
Kent Co. Mon. (I-1, T5N, R10W)	West 40.25'

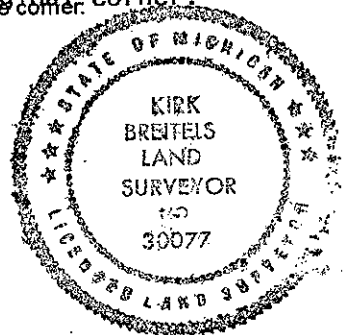

Signed by Kirk Breitels  
Surveyor's Michigan License No. 30077

Date 4/19/96