

OCT 28 1994

KENT COUNTY REMONUMENTATION

LAND CORNER RECORDATION CERTIFICATE
Filing Requirement of Act 74, Mich. P.A. 1970

STATE OF MICHIGAN
COUNTY OF KENT
RECEIVED FOR RECORD

94 JUL -5 PM 3:11

For corners in
KENT COUNTY
(County)

CASCADE TWP

Located In: Corner Code #/

- | | | |
|---------------------------------------|--------------------------|-----------------------|
| 1. Public Land Survey | T <u>6N</u> R <u>10W</u> | <u>J-2 C 1/4 cor.</u> |
| | T ___ R ___ | <u>Sec. 2</u> |
| | T ___ R ___ | _____ |
| | T ___ R ___ | _____ |
| 2. Property Controlling in Section | S ___ T ___ R ___ | _____ |
| | S ___ T ___ R ___ | _____ |
| 3. Miscellaneous Property in Sec. | S ___ T ___ R ___ | _____ |
| | S ___ T ___ R ___ | _____ |
| 4. Lot No. _____, Recorded Plat _____ | | |
| 5. Private Claims _____ | | |

W. R. Byl
REG. OF DEEDS

6945

Register of Deeds Stamp & File Number

I, William R. Byl, in a field survey on June 28, 19 94, do hereby certify that under requirements of P.A. 74, Michigan P.A. of 1970, the corner points mentioned in lines 1 and 2 above were in conformance with regulations and rules therefore as required in the current manual of survey instructions of the United States Department of the Interior, Bureau of Land Management or by a decree of a Court of Law and/or that the corner points mentioned in lines 3, 4 and 5 above were in conformance with the rules of the Michigan Board of Land Surveyors or by a Decree of a Court of Law; established, re-established, monumented, re-monumented, recovered, found as expressed below:

A	B	C	D	E	F	G	H	I	J	K	L	M
2	6	5	4	3					2			
3												
4	7	8	9	10	11	12						
5												
6	18	17	16	15	14	13						
7												
8	19	20	21	22	23	24						
9												
10	30	29	28	27	26	25						
11												
12	31	32	33	34	35	36						
13												

NOTE: Not more than 4 corners, all in the same town and range, may be recorded on this certificate.

A. Description of original monument and accessories and/or subsequent restoration:

J-2 Williams & Works 1907
Made E-W 1/4 line parallel with the S. line of the Sec. and 2660' N. of it.
Set Stone at C 1/4 cor.

Williams & Works Sept. 13, 1973
"T" Iron (LCRC #575)
10" Cedar N15°W 31.80'
10" Maple S80°E 10.55'
8" Poplar N70°W 10.04'

P.A. 345 1990 KENT COUNTY
PEER APPROVED 3/24/94

CHAIRMAN Hayes Huber

B. Description of corner evidence found and/or method applied in restoring or reestablishing corner:

J-2 Found "T" Iron per LCRC #575. "T" iron is approximately 105' North of being parallel with the South line of Section 2. Computed the location of C 1/4 cor. per method used in Williams & Works 1907 survey and looked 105' S. of "T" Iron. Found 1'x 1'x 1' pyramid stone, point sticking out of ground 3", with smaller stones and pieces of broken brick underneath. Stone is 3.0' North of a line from the W 1/4 and parallel with the South line of Section 2 and is 1.1' East of the N-S 1/4 line as established by the S 1/4 cor. and an iron (KC Wit. Mon. set 10' S. of iron) found at the N. end of a fence on the top of slope of the S. bank of the Grand River. "T" Iron is North 102.21'.


Corner "M" on recorded survey of Sections 1 & 2-6-10

Recorded survey L 265 P 21

C. Description of monument for corner and accessories established to perpetuate locating the position of the corner:

J-2 Replaced Stone with Standard Kent County Monument

- | | | |
|---|-------|--------|
| Set Nail & KC Remon. tag E. side 24" Maple | S10°E | 21.33' |
| Set Nail & KC Remon. tag W. side Power Pole | N30°E | 13.16' |
| Set Nail & KC Remon. tag S. side 10" Poplar | N70°W | 36.11' |
| Set Nail & KC Remon. tag NW side 6" Oak | S65°W | 17.21' |
| "T" Iron North 102.21' | | |
| N-S fence East 8' | | |

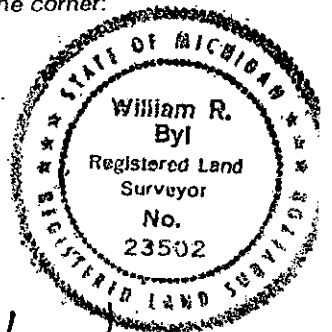

Signed by W. R. Byl
Surveyor's Michigan License No. 23502

Date 06/27/94