

**SURVEY & RE-MONUMENTATION**

**KENT COUNTY REMONUMENTATION**

**LAND CORNER RECORDATION CERTIFICATE**  
 Filing Requirement of Act 74, Mich. P.A. 1970

FEB 14 1997

For corners in

KENT COUNTY Located In:

Corner Code #

(County)

- |                                    |              |               |            |
|------------------------------------|--------------|---------------|------------|
| 1. Public Land Survey              | T <u>6</u> N | R <u>10</u> W | <u>J-4</u> |
|                                    | T            | R             |            |
|                                    | T            | R             |            |
|                                    | T            | R             |            |
| 2. Property Controlling in Section | S            | T             | R          |
|                                    | S            | T             | R          |
| 3. Miscellaneous Property in Sec.  | S            | T             | R          |
|                                    | S            | T             | R          |

STATE OF MICHIGAN  
 COUNTY OF KENT  
 RECEIVED FOR RECORD  
 96 SEP 13 PM 12:06  
 REG. OF DEEDS  
*[Signature]*

**9367**

Register of Deeds Stamp & File Number

4. Lot No. \_\_\_\_\_, Recorded Plat \_\_\_\_\_  
 5. Private Claims \_\_\_\_\_

I, Kirk Breitels, in a field survey on Aug. 28, 1996 do hereby state that under requirements of P.A. 74, Michigan P.A. of 1970, the corner points mentioned in lines 1 and 2 above were in conformance with regulations and rules therefore as required in the current manual of survey instructions of the United States Department of the Interior, Bureau of Land Management or by a decree of a Court of Law and /or that the corner points mentioned in lines 3, 4 and 5 above were in conformance with the rules of the Michigan Board of Land Surveyors or by a Decree of a Court of Law; established, re-established, monumented, recovered, found as expressed below:

A	B	C	D	E	F	G	H	I	J	K	L	M
1												
2	6	5	4	3	2	1						
3												
4	7	8	9	10	11	12						
5												
6	18	17	16	15	14	13						
7												
8	19	20	21	22	23	24						
9												
10	30	29	28	27	26	25						
11												
12	31	32	33	34	35	36						
13												

NOTE: Not more than 2 corners, all in the same town and range, may be recorded on this certificate.

**A. Description of original monument and accessories and/or subsequent restoration:**

- J-4 1831---GLO---Not Set  
 1936---Williams & Works---Center by fences E-W & N-S  
 1965-67---Williams & Works---Center by computations - not monumented  
 1979---LCRC #1377---VanKooten---Set by intersection 1/4 lines  
 12" Oak W 11.61' 14" Ash NNE 9.92' 8" Oak SW 16.74' 18" Oak SSW 30.31'  
 Fence to East - N 10' Fence to West - N 1' N-S fence - W 11'  
 1990---Survey---Exxel Eng.---Rerod and MVK cap (wits. same as LCRC #1377)

**B. Description of corner evidence found and/or method applied in restoring or reestablishing corner:**

- J-4 Found Rerod with MVK cap per the following witnesses:  
 14" Oak W 11.6' 18" Ash NNE 9.8' 22" Oak SW 16.7'  
 Fence to E - N 10'


P.A. 345 1990 KENT COUNTY  
 PEER APPROVED 8/22/96  
 CHAIRMAN [Signature]

Said Rerod with MVK cap is 0.6' N. and 0.1' W. from intersection of 1/4 lines and agrees with survey measurements of others.

The Rerod with MVK cap is accepted by me and is generally accepted by professional surveyors as the best available evidence of the position of the corner.

**C. Description of monument for corner and accessories established to perpetuate locating the position of the corner:**

- J-4 Set Standard Kent County Monument in place of the Rerod with MVK cap.  
 Set Nail & KC Remon. tag S. side 14" Oak S90°W 11.62'  
 Set Nail & KC Remon. tag W. side Twin 18" Ash N20°E 9.78'  
 Set Nail & KC Remon. tag NW side 22" Oak S60°W 16.70'  
 Set Nail & KC Remon. tag W. side Tri. 20" Oak S25°W 32.46'  
 Set Nail & KC Remon. tag NE side 12" Hickory S15°E 37.02'  
 Fence to East is 10' North  
 Fence cor. for fences North & West is 12' West

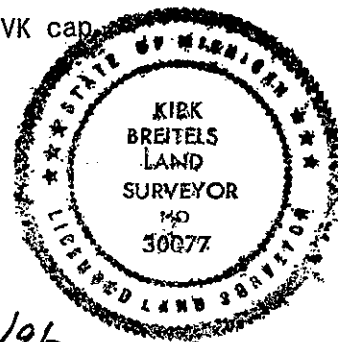

Signed by [Signature]  
 Surveyor's Michigan License No. 30077

Date 9/4/96